

SURVEY & REMONUMENTATION

1993

LAND CORNER RECORDATION CERTIFICATE Filing Requirement of Act 74, Mich. P.A. 1970

COMMISSION

For corners in

Manistee (County)

Located In:

Corner Code ##

1. Public Land Survey

T R

T R

T R

T R

2. Property Controlling in Section

S 9 T 21N R 13W

S T R

3. Miscellaneous Property in Sec.

S T R

S T R

Other #3

REGISTER'S OFFICE
MANISTEE COUNTY

#93-322 AT 2:42 p.m.
MAY 12 1993

Benny A. Peppas
REGISTER OF DEEDS

Register of Deeds Stamp & File Number

4. Lot No. , Recorded Plat

5. Private Claims

I, Norman C. Caldwell, in a field survey on September, 19 92, do hereby certify that under requirements of P.A. 74, Michigan P.A. of 1970, the corner points mentioned in lines 1 and 2 above were in conformance with regulations and rules therefore as required in the current manual of survey instructions of the United States Department of the Interior, Bureau of Land Management or by a decree of a Court of Law and/or that the corner points mentioned in lines 3, 4 and 5 above were in conformance with the rules of the Michigan Board of Land Surveyors or by a Decree of a Court of Law; established, re-established, monumented, re-monumented, recovered, found as expressed below:

NOTE: Not more than 4 corners, all in the same town and range, may be recorded on this certificate.

A. Description of original monument and accessories and/or subsequent restoration:

9-15 This position not established by original government survey.

9-15.5 Post established by J. Brink, 1838
N69°E 26 lks. (17.16') 14" Y. Pine
S16°E 19 lks. (12.54') 14" Y. Pine

B. Description of corner evidence found and/or method applied in restoring or reestablishing corner:

9-15 W 1/16 cor., Sec. 9 & 16, T21N-R13W
No Subsequent Record

9-15.5 I.R. Boundary Sec. 9 & 16, T21N-R13W
No Subsequent Record


C. Description of monument for corner and accessories established to perpetuate locating the position of the corner:

9-15 W 1/16 cor., Sec. 9 & 16, T21N-R13W

Placed 5/8" bar w/alum. cap. This position not established by original gov't survey. This monument is accepted as a careful and faithful determination of the position of the corner.
S32°E 95.64' P.L.P.
S14°W 46.65' 4" W. Pine
S45°W 85.30' 14" W. Oak
N18°E 73.03' 20" W. Oak
South 25.00' Carsonite Witness Post

9-15.5 I.R. Boundary Sec. 9 & 16, T21N-R13W

Place 5/8" bar w/alum. cap 12"± S CL M-55 and is accepted as a careful and faithful reestablishment of the position of the original corner.
N25°W 78.95' 7" B. Oak
S32°E 24.51' 12" W. Oak
S45°W 52.41' 7" W. Oak
N22°E 83.92' 8" Twin W. Oak
South 25.00' Carsonite Witness Post
East 359.83' 1/4 cor., Sec. 9 & 16, T21N-R13W

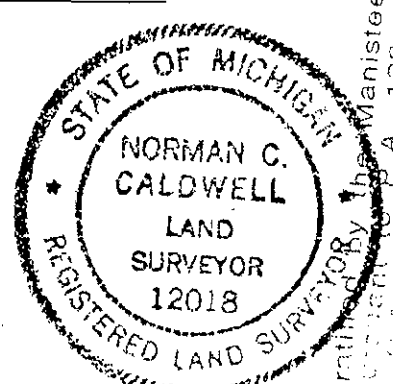

Corner 1 - 15.5
County Peer Group Surveyed by P.A. 123 of 1915, as amended by P.A. 345 of 1990, as amended. Date of Peer Group Survey April 8, 1993

Signed by Norman C. Caldwell

Date 13 JAN 93

Surveyor's Michigan License No. 12018