

1993

# LAND CORNER RECORDATION CERTIFICATE

## Filing Requirement of Act 74, Mich. P.A. 1970

COMMISSION

For corners in  
Manistee

(County)

Located In:

Corner Code #

#004

REGISTER'S OFFICE  
MANISTEE COUNTY

# 93-329 PT 3 16 p.m.  
MAY 12 1993

*Penny A. Peyer*  
REGISTER OF DEEDS

Register of Deeds Stamp &amp; File Number

1. Public Land Survey

21N 13W  
T R  
T R  
T R  
T R

E-5.5, E-F-5/6

E06i

2. Property Controlling  
in Section

S T R  
S T R

3. Miscellaneous  
Property in Sec.

S T R  
S T R

4. Lot No. \_\_\_\_\_, Recorded Plat \_\_\_\_\_

5. Private Claims \_\_\_\_\_

I, Norman C. Caldwell, in a field survey on September, 1992

do hereby certify that under requirements of P.A. 74, Michigan P.A. of 1970, the corner points mentioned in lines 1 and 2 above were in conformance with regulations and rules therefore as required in the current manual of survey instructions of the United States Department of the Interior, Bureau of Land Management or by a decree of a Court of Law and/or that the corner points mentioned in lines 3, 4 and 5 above were in conformance with the rules of the Michigan Board of Land Surveyors or by a Decree of a Court of Law, established, re-established, monumented, re-monumented, recovered, found as expressed below:

NOTE: Not more than 4 corners, all in the same town and range, may be recorded on this certificate.

A. Description of original monument and accessories and/or subsequent restoration:

E-5.5 I.R. Boundary bet. Sec. 16 & 17, post established by John Brink, August 1, 1837.  
S50°W 35 lks. (23.10') 8" Hemlock  
S85°E 54 lks. (35.64') 11" Hemlock

E-F-5/6

S.E. Corner of I.R., post established by John Brink, May 1837.  
S57°E 35 lks. (23.10') 12" Y. Pine  
N44°W 65 lks. (42.90') 14" Y. Pine

B. Description of corner evidence found and/or method applied in restoring or reestablishing corner:


E-5.5 Cor. common to Gov't Lots 1 &amp; 8, Sec. 17, T21N-R13W

E-F-5/6

SE cor. Indian Res. boundary Sec. 16, T21N-R13W

No Subsequent Record

No Subsequent Record

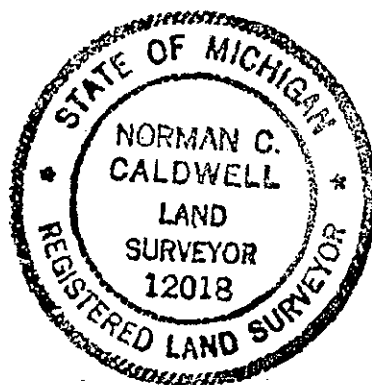

C. Description of monument for corner and accessories established to perpetuate locating the position of the corner:

E-5.5 Cor. common to Gov't Lots 1 &amp; 8, Sec. 17, T21N-R13W

E-F-5/6

SE cor. Indian Res. boundary Sec. 16, T21N-R13W

Placed 2" diam. iron pipe w/brass cap 35± W. of W. bank Pine River and is accepted as a careful and faithful reestablishment of the position of the original corner.

N12°W 37.70' 6" W. Pine  
S58°E 36.45' 6" W. Oak  
S12°E 38.72' 6" W. Oak  
N69°W 43.52' S.E. Cor. Building  
North 1.0' Carsonite Witness Post  
South 198.42' 1/4 cor., Sec. 16 & 17, T21N-R13W  
(IN RIVER)

Placed 2" diam. iron pipe w/brass cap and is accepted as a careful and faithful reestablishment of the position of the corner.

S27°E 14.61' 4" W. Pine  
S60°W 14.67' 14" W. Oak  
N09°E 39.43' 12" W. Oak  
N80°E 47.95' 10" W. Oak  
North 1.0' Carsonite Witness Post

Signed by

Date

12 JAN 93

Surveyor's Michigan License No.

12018