

SURVEY &
REMONUMENTATION

APR 29 1996

COMMISSION

LAND CORNER RECORDATION CERTIFICATE
Filing Requirement of Act 74, Mich. P.A. 1970

JAN 24 1996

COMMISSION

For corners in
Manistee

(County)

Located In:

Corner Code ##

1. Public Land Survey

21N 13W
T R
T R
T R
T R

A-6

M-06
OF
T21N R13W
T21N R14W

2. Property Controlling
in Section

S 18 T 21N R 13W
S T R
S T R
S T R

18-15

3. Miscellaneous
Property in Sec.

4. Lot No. , Recorded Plat

5. Private Claims

REGISTER'S OFFICE
MANISTEE COUNTY

#93-317 AT 3:14 p.m.

MAY 12 1993

Penney A. Peper
REGISTER OF DEEDS

Register of Deeds Stamp & File Number


I, Norman C. Caldwell, in a field survey on September, 19 92,
do hereby certify that under requirements of P.A. 74, Michigan P.A. of 1970, the corner points mentioned
in lines 1 and 2 above were in conformance with regulations and rules therefore as required in the
current manual of survey instructions of the United States Department of the Interior, Bureau of Land
Management or by a decree of a Court of Law and/or that the corner points mentioned in lines 3, 4 and 5
above were in conformance with the rules of the Michigan Board of Land Surveyors or by a Decree of a
Court of Law; established, re-established, monumented, re-monumented, recovered, found as
expressed below:

NOTE: Not more than 4 corners, all in the same town and range, may be recorded
on this certificate.

A. Description of original monument and accessories and/or subsequent restoration:

A-6 Post placed by John Brink, Sept. 1837
N61°W 35 lks. (23.10') 11" Birch
S37°W 45 lks. (29.70') 10" Birch

18-15 This position not established by
original government survey.

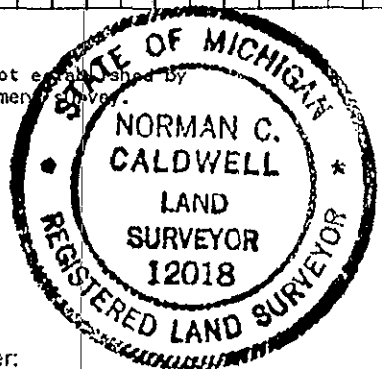

B. Description of corner evidence found and/or method applied in restoring or reestablishing corner:

A-6 1/4 common to Sec. 18, T21N-R13W & Sec. 13, T21N-R14W

18-15 W 1/16 cor., Sec. 18 & 19, T21N-R13W

County Surveyors record S. H. Baker - date unknown
No Monument Given
N37°E 78.7' 8" Water Elm
S58°W 46' 14" Hemlock Stump

County Surveyors Record Fargo Eng. Co. December 1907
Monument - Gas Pipe
S29°W 26.00' 10" Tamarak
S78°E 28.00' 8" Tamarak

County Surveyors copy of minutes of Survey Theodore Norlin
in June 1922
Fnd. old stake
S14°W 55.3' 18" B. Oak
S68°E 46.0' 15" Maple

County Surveyors copy of minutes of Survey
Theodore Norlin in June 1922
Monument - stake
S29°W 26.00' 10" Tamarak
S78°E 28.00' 8" Tamarak

Unrecorded survey by K. Ross in 1973
Monument - 1" Pipe
East 25.76' 12" W. Pine
SW 14.20' 10" W. Pine
NW 29.78' 12" W. Pine
(Fnd. in U.S.F.S. Land Corner Record)

C. Description of monument for corner and accessories established to perpetuate locating the position of the corner:

A-6 1/4 common to Sec. 18, T21N-R13W & Sec. 13, T21N-R14W

18-15 W 1/16 cor., Sec. 18 & 19, T21N-R13W

At prop. distance, found
No evidence of record monument, placed 2" iron pipe with
brass cap and is accepted as a careful and faithful
reestablishment of the position of the original corner.

S42°W 52.33' 15" W. Pine
N55°W 25.57' 18" W. Pine
S52°E 46.28' 18" W. Pine
N38°E 74.85' 20" W. Pine
N01°E 230.62' 3/4" Pipe #12018 5' conc. mon. @
North 1.0' Carsonite Witness Post I.R. BOUNDARY
179.96 NCC

Fnd. 1 1/2" diam. Iron pipe, placed 5/8" x
reord w/alum. cap inside existing iron pipe
is 1.2" above conc. block. This position not
established by original government survey,
monument is accepted as a careful and faithful
determination of the position of the corner.
S10°E 33.15' 8" W. Pine
S80°W 53.93' 9" W. Pine
N30°W 29.53' 5" W. Pine
N81°E 22.01' 7" W. Pine
West 1.0' Carsonite Witness Post

Signed by *Norman C. Caldwell*

Date

Surveyor's Michigan License No. 12018

12 JAN 93
FORM APPROVED BY MICHIGAN STATE BOARD OF LAND SURVEYORS, JAN. 28, 11
REVISED MAY 14, 11
REVISED JAN., 11

A-6 M6 ratified by the Manistee
County Peer Group pursuant to P.A. 123 of
1915, as amended by P.A. 345 of 1990, as
amended. Date of Peer Review: APRIL 1993