

LAND CORNER RECORDATION CERTIFICATE
Filing Requirement of Act 74, Mich. P.A. 1970

SECTION

For corners in

Manistee
(County)

Located In:

Corner Code =#

1. Public Land Survey

T 21N R 14W

T R

T R

T R

2. Property Controlling
in Section

S T R

S T R

3. Miscellaneous
Property in Sec.

S T R

S T R

4. Lot No. , Recorded Plat

5. Private Claims

G-10, F-11

REGISTER'S OFFICE
MANISTEE COUNTY

#93-497 AT 3:25 p.m.

AUG 18 1993

Penny A. Papera
REGISTER OF DEEDS

Register of Deeds Stamp & File Number

I, Norman C. Caldwell, in a field survey on May, 19 93, do hereby certify that under requirements of P.A. 74, Michigan P.A. of 1970, the corner points mentioned in lines 1 and 2 above were in conformance with regulations and rules therefore as required in the current manual of survey instructions of the United States Department of the Interior, Bureau of Land Management or by a decree of a Court of Law and/or that the corner points mentioned in lines 3, 4 and 5 above were in conformance with the rules of the Michigan Board of Land Surveyors or by a Decree of a Court of Law; established, re-established, monumented, re-monumented, recovered, found as expressed below:

NOTE: Not more than 4 corners, all in the same town and range, may be recorded on this certificate.

A. Description of original monument and accessories and/or subsequent restoration:

G-10 Post placed by J. Brink in 1842 subdivision survey.
S31°E 14 lks. (9.2') 8" Hemlock
N79°W 10 lks. (6.6') 8" Hemlock

F-11 Post placed by John Brink in 1842 subdivision survey.
S11°W 33 lks. (21.8') 12" Hemlock
N68°E 42 lks. (27.7') 10" White Pine

B. Description of corner evidence found and/or method applied in restoring or reestablishing corner:

G-10 1/4 cor., Sec. 27 & 28, T21N-R14W
No subsequent record.

F-11 1/4 cor., Sec. 28 & 33, T21N-R14W
No subsequent record.

NOTE: This form is revised to meet requirements of Manistee County Peer Review Committee.

C. Description of monument for corner and accessories established to perpetuate locating the position of the corner:

G-10 1/4 cor., Sec. 27 & 28, T21N-R14W


Placed 5" x 5" x 36" conc. monument w/brass tablet by record dist. from South and verified by original dist. to old ridge along Lake Shore North and is accepted as a careful and faithful reestablishment of the position of the original corner.
N83°W 17.38' 8" S. Maple
N24°W 28.59' 8" S. Maple
S63°W 43.34' 8" S. Maple
S51°E 12.17' 12" S. Maple

F-11 1/4 cor., Sec. 28 & 33, T21N-R14W

Placed 5" x 5" x 36" conc. monument w/brass tablet by single proportion between acceptable section corners 1/2 mile East and West, and is accepted as a careful and faithful reestablishment of the position of the original corner.
N65°E 18.41' 6" S. Maple
S34°E 55.00' 4" White Pine
S40°W 59.26' 8" White Oak
N50°W 34.19' 4" White Pine
NW .5' Carsonite Witness Post

Signed by Norman C. Caldwell
Surveyor's Michigan License No. 12018

Date 2 JUNE 1993

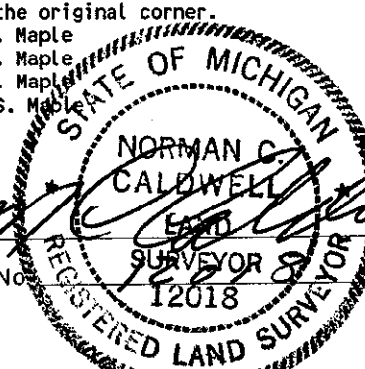

	A	B	C	D	E	F	G	H	I	J	K	L	M
2	6		5		4		3		2		1		
3													
4	7		8		9		10		11		12		
5													
6	18		17		16		15		14		13		
7													
8	19		20		21		22		23		24		
9													
10	30		29		28		27		26		25		
11													
12	31		32		33		34		35		36		
13													

Corner G-10 ratified by the Manistee County Peer Group pursuant to P.A. 123 of 1995, as amended by P.A. 345 of 1990, as amended. Date of Peer Review: APRIL 5, 1993

Corner F-11 ratified by the Manistee County Peer Group pursuant to P.A. 123 of 1995, as amended by P.A. 345 of 1990, as amended. Date of Peer Review: JUNE 7, 1993

APPROVED JUN 7 1993