
## SURVEY & REMONUMENTATION

## LAND CORNER RECORDATION CERTIFICATE APR () 3 1996 FILING REQUIREMENT OF ACT 74, MICH. P.A.1970

			4
FOR CORNERS OF -:	LOCATED IN-:	CORNER CODE NUMBER	
1. PUBLIC LAND SURVEY	22N <sub>N.</sub> 13W T S., R	E. EB(i) OTHER II	REGISTER'S OFFICE
2. PROPERTY CONTROLL-	N. S., R	E. W.	MANISTEE COUNTY #95-239 BT 11:05 A-M - JUN 2 2 1995
3. MISCELLANEOUS PROPERTY IN SECTION.			- Permy a Rosse
4. LOT NO, REC	ORDED PLAT		REGISTER OF DEEDS
5. PRIVATE CLAIMS			REGISTER OF DEEDS STAMP AND
field survey on April, 17	1995, establis	shed, re-established, monume	of P.A.74, Michigan P.A. of 1970 dex code diagram - over) were, in ented, re-monumented, recovered of
of survey instructions of the court of law. Furthermore 19	United States Department  t, that the corner points found, recovered, restore	of the Interior, Bureau of La s mentioned in lines 3,4 an ed, established or re-establish	e as required in the current manus and Management or by a decree of d 5 above were, in a field survey of the das expressed below and in con- eyors or, by a Decree of a Court
law:			to the state of the country of the country of the state of the country of the cou
A. Description of original mo	nument and accessories	ra.	II .
1837 GLO survey of the Ma 1839 GLO survey by John I NE comer of the reservation, 1847 GLO survey within the 1900 survey by Jos. Millard (3) W.Pine Stub 14 N87-30M 1988 survey by Patrick R. I post with a 5"x5"x60" concret	nistee Indian Reservation by Jarink Set a wood post at the into (1) Maple 10 N55W 13 links, (e. Manistee Indian Reservation I County Surveyor Found the N / 29.5, links, (4) W.Pine Stub N8.eemon #3195 Found a fence e monument with brass cap (5)	by Orange Risdon Intersected the re lable GLO BT and point of stake	eservation boundary  ced the fence corner
B. Description of corner evid	lence found and/or metho	d applied in restoring or re-es	stablishing corner:
I found the 5"x60" mon Witnesses 1, 2 and 4 a condition. Liber 88 Pa	ument extending 18" abo are gone. Witness 3 is a ge 29 by Leemon docum	ove the surface and in good conductive decayed mound and witness ents the history of this corner of the position of the original	ondition: 5 is in poor . I accept this
		•	
Indian Reserve Corne	er common to Sections ete monument w/ brass ca 3.01 feet puth 1.94 feet .10 feet Com 71 feet acc 90 feet as a	20 and 21 of T22N R13W ap as I found it.  Ther E - D 8 i ratified profing to the county plan adoption amended, (being the State Survey area.). Date of Peer Review:	d by the Manistee County Peer Group ted pursuant to P.A. 345 of 1990, y and Remonument Act, MCL 54.261
		Quello	y m. Slowish
SIGNED BY Taken	1 Q. Sum		May 30, 1995
SURVEYOR'S MICHIGAN R	EGISTRATION NO	31595	(FSEAL)
FOR STATE AND UNITED	STATES AGENCIES:		PATRICK &
SIGNED BY State	CHIEF OF SURVEY PARTY	DATE	LEEMON LAND SURVEYOR
APPROVED AND SIGNED E	BYMICHIGAN REGISTE	RED LAND SURVEYOR DAT	121
•			448 8

SURVEYOR'S MICHIGAN REGISTRATION NO.

## CORNER NUMBERING CODE DIAGRAMS FOR IDENTIFYING LAND CORNER RECORDATIONS AND INDEXING

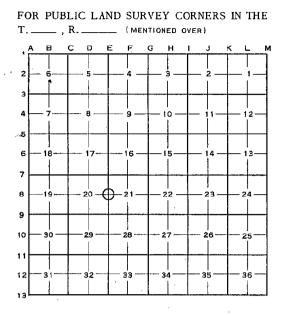


Apply letter prefix for corner points encircled above for identifying corner recordation numbers over.

REGISTER'S OFFICE MANISTEE COUNTY

#95:231 AT 11:05 A.M. JUN 2 2 1995

Permy Q. Peoila.
(REGISTER OF DEEDS

FOR PROPERTY CONTROLLING AND MISC. PROPERTY CORNERS WITHIN THE SECTION (MENTIONED OVER AND EXCLUDE LOT CORNER)

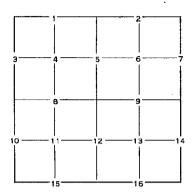

- 1. Above coded numbers are positioned on 1/16 fractional lines of the section.
- 2. Township corner code numbers shall be applied to corners of above typical section not numbered.
- Miscellaneous property corners within a section, located at points other than numbered above, shall be referenced to at least two of above corner code numbers.
- 4. Private claim corners to be tied to rectangular land corners if possible sketch required below.

EXPLANATORY SKETCH IF NECESSARY -- BELOW