

LAND CORNER RECORDATION CERTIFICATE

Filing Requirement of Act 74, Mich. P.A. 1970

1993

For corners in

<u>MANISTEE</u> <small>(County)</small>	Located In:	Corner Code <u>##</u>	
1. Public Land Survey	T <u>23N</u> R <u>16W</u>	<u>Meander Corner</u>	
	T _____ R _____	<u>Sec's. 21 & 28</u>	
	T _____ R _____		
	T _____ R _____		
2. Property Controlling in Section	S _____ T _____ R _____	<u>Other #1</u>	
	S _____ T _____ R _____		
	S _____ T _____ R _____		
3. Miscellaneous Property in Sec.	S _____ T _____ R _____		

COMMISSION
REGISTER'S OFFICE
MANISTEE COUNTY
93-689 AT 4:40 p.m.
DEC 21 1993
Penny A. Repora
REGISTER OF DEEDS

Register of Deeds Stamp & File Number

4. Lot No. _____, Recorded Plat _____
5. Private Claims _____

I, Sammy S. Barnett, in a field survey on November 29, 19 93, do hereby certify that under requirements of P.A. 74, Michigan P.A. of 1970, the corner points mentioned in lines 1 and 2 above were in conformance with regulations and rules therefore as required in the current manual of survey instructions of the United States Department of the Interior, Bureau of Land Management or by a decree of a Court of Law and/or that the corner points mentioned in lines 3, 4 and 5 above were in conformance with the rules of the Michigan Board of Land Surveyors or by a Decree of a Court of Law; established, re-established, monumented, re-monumented, recovered, found as expressed below:

NOTE: Not more than 4 corners, all in the same town and range, may be recorded on this certificate.

A. Description of original monument and accessories and/or subsequent restoration:

Meander Corner, Sections 21 & 28, T23N, R16W)

1839, John Brink D.S., G.L.O.
Placed Wood Stake

- | | | | |
|----|----------|-------|--------|
| #1 | 8" Cedar | N27°E | 8 lks. |
| #2 | 6" Cedar | S47°E | 9 lks. |

B. Description of corner evidence found and/or method applied in restoring or reestablishing corner:

Meander Corner, Sections 21 & 28, T23N, R16W



Due to the lack of any exciting evidence, established the position of the meander corner at G.L.O. distance from 1/4 corner for sections 21 & 28, on a straight line through the South 1/4 corner to the Southeast corner of section 21.
Condition of recorded witnessess. #1 Gone #2 Gone

C. Description of monument for corner and accessories established to perpetuate locating the position of the corner:

Meander Corner, Sections 21 & 28, T23N, R16W

Placed Manistee County Monument (2 1/2" x 30" steel pipe with brass cap), and is accepted as the best available evidence of the position of the original corner.

- | | | | |
|--------------|-------|--------|--------------------------------|
| 14" Hemlock | N60°W | 33.10' | (60d spike in SW side of tree) |
| 10" R. Maple | S52°W | 25.59' | (60d spike in NW side of tree) |
| 10" R. Maple | N61°E | 12.95' | (60d spike in NW side of tree) |
| 6" B. Ash | S57°E | 39.24' | (60d spike in SW side of tree) |

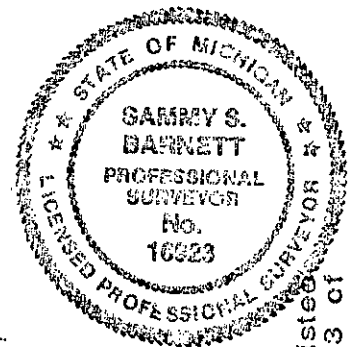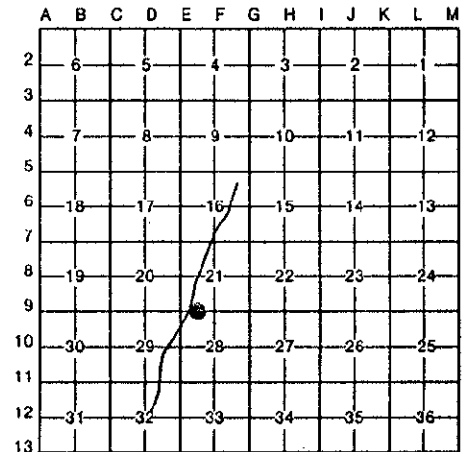

Corner C - 2 (corner of) Manistee County Peer Group pursuant to P.A. 123 of 1915, as amended by P.A. 345 of 1990, as amended. Date of Peer Review: _____

Signed by Sammy S. Barnett Date 12/31/93

Surveyor's Michigan License No. 16923