

SURVEY & REMONUMENTATION

MECOSTA COUNTY REMONUMENTATION PROGRAM

JUL 06 1998

CORNER APPROVED BY PEER GROUP ON December 12, 1997

SECTION

LAND CORNER RECORDATION CERTIFICATE

Filing Requirement of Act 74, Mich. P.A. 1970

STATE OF MICHIGAN
COUNTY OF MECOSTA
RECEIVED FOR RECORD

'98 APR 10 A10:35

Joanne Brown
REGISTER OF DEEDS

Register of Deeds Stamp & File Number

For corners in

Mecosta

(County)

Located In:

Martiny Township

Corner Code #

1. Public Land Survey SEC 27 T15N R08W
T R
T R
T R
2. Property Controlling in Section S T R
S T R
3. Miscellaneous S T R
Property in Sec. S T R

G-11

4. Lot No. Recorded Plat
5. Private Claims

I, James J. Keller, in a field survey on November 28 1997, do hereby certify that under requirements of P.A. 74, Michigan P.A. of 1970, the corner points mentioned in lines 1 and 2 above were in conformance with regulations and rules therefore as required in the current manual of survey instructions of the United States Department of the Interior, Bureau of Land Management or by a decree of a Court of Law and/or that the corner points mentioned in lines 3, 4 and 5 above were in conformance with the rules of the Michigan Board of Land Surveyors or by a Decree of a Court of Law, established, re-established, monumented, re-monumented, recovered, found as expressed below:

NOTE: Not more than 2 corners, all in the same town and range, may be recorded on this certificate.

A. Description of original monument and accessories and/or subsequent restoration:

December 17, 1838, Noah Brookfield, Deputy Surveyor G.L.O. "To 20" Pine for Cor. Sect. 27, 28, 33 & 34"

September 13, 1916, EE Sours, Mecosta County Road Survey "Sec 27, 28, 33 & 34"
Red Oak N43°W 33.0' W. Oak S66°E 89.5'

March 25, 1975, Clinton E. Cole R.L.S. #17615 (L.C.R.C. Liber 1, Page 184) "Found 3/8" Rod inside 2" pipe at intersection of Roads"
4' High T. Pole N46°W 46.72' Fence Post N46°W 46.72' 1/4" Nut on top of Buried Tel Cable riser S32°W 68.03'

October 25, 1979, Jerome A Schafer R.L.S. #16409 (Survey Liber 10, Page 786/787/788) "Found 3/4" Pipe"
No Witnesses Given

November 28, 1988, Burt Wickham Jr. R.L.S. #17639 (L.C.R.C. Liber 2, Page 244) "Prev. Recorded Liber 1, Page 184, Found 3/4" Pipe witness to Cable Riser checked & Fence Post Gone"
Pk SE side T. Pole N45°E 53.30' Pk E side T. Pole S30°W 68.44' Nail E side P. Pole N30°W 67.50'

December 29, 1995, William G. Tingley R.L.S. # 30104 (Survey Liber 12, Page 94/95) "Found 3/4" IP Set over Clay Tile"
Found Pk Riser Box Post N40°E 52.84' Found Nail P. Pole N35°W 67.07'
Found Nail P. Pole S40°W 68.64' Set Nail & Tag Corner Fence Post S45°E 60.50'

B. Description of corner evidence found and/or method applied in restoring or reestablishing corner:

November 28, 1997, James J. Keller R.L.S. #10693 (Field Book 138W, Page 50) "Found 3/4" Iron Pipe 3' E Centerline Road"
Found Form Nail NE side P. Pole N32°W 67.23'
Found Pk SE side Stub T. Pole N50°E 52.95'
Found Nail & Tag #30104 Corner Fence Post S50°E 60.65'
Found Pk SE side T. Pole S32°W 68.90'

APPROVED BY MECOSTA CO. PEER GROUP
IN ACCORDANCE WITH P.A. 345 of 1990

CHAIRMAN

DATE

DEC. 12, 1997

C. Description of monument for corner and accessories established to perpetuate locating the position of the corner:

Accepted clay tiles and set remonumentation monument in box as a careful and faithful perpetuation of the location of the Original Corner.


Found Form Nail and set 60d and Tag above NE side P. Pole N32°W 67.23'
Found Pk and set Tag SE side Stub T. Pole N50°E 52.95'
Found Nail & Tag #30104 and set Pk and Tag above Corner Fence Post S50°E 60.65'
Found Pk and set Tag SE side T. Pole S32°W 68.90'

Signed by

James J. Keller

Date December 16, 1997

Surveyor's Michigan License No. 10693

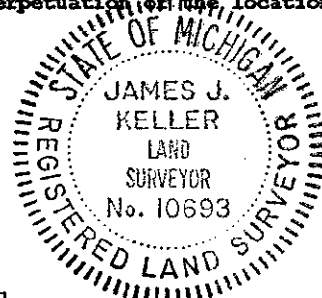

SURVEY &
REMONUMENTATION


JUL 06 1998

SECTION

12 -16 -1997

LJH

as Found

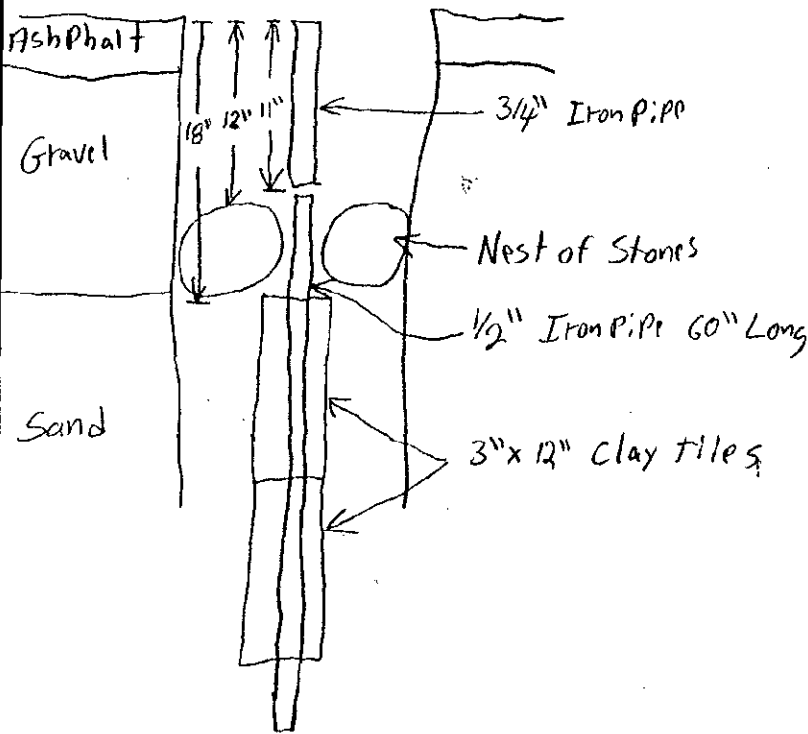

as set

