

LAND CORNER RECORDATION CERTIFICATE Filing Requirement of Act 74, Mich. P.A. 1970

For corners in

MECOSTA
(County)

Located In:

Corner Code --#

1. Public Land Survey

T 16N R 09W
T 16N R 09W
T 16N R 09W

C-11

D-11

E-11

2. Property Controlling
in Section

S 32 T 16N R 09W

1

3. Miscellaneous
Property in Sec.

S T R
S T R
S T R

Register of Deeds Stamp & File Number

4. Lot No. _____, Recorded Plat _____

5. Private Claims _____

I, CARL F. ROSER, in a field survey on 12/17, 19 87,

do hereby certify that under requirements of P.A. 74, Michigan P.A. of 1970, the corner points mentioned in lines 1 and 2 above were in conformance with regulations and rules therefore as required in the current manual of survey instructions of the United States Department of the Interior, Bureau of Land Management or by a decree of a Court of Law and/or that the corner points mentioned in lines 3, 4 and 5 above were in conformance with the rules of the Michigan Board of Land Surveyors or by a Decree of a Court of Law; established, re-established, monumented, re-monumented, recovered, found as expressed below:

NOTE: Not more than 4 corners, all in the same town and range, may be recorded on this certificate.

XX
A. Description of original monument and accessories and/or subsequent restoration.

C CONT'D.

1
DROVE 5/8" X 34" REROD W/RLS CAP & SET
CED POST W/LOC TAG

2" MAPLE	N60°W	5.3'
12" R.OAK	S35°E	20.5'
5" R.OAK	S70°W	43.7'

B. Description of corner evidence found and/or method applied in restoring or reestablishing corner:

C-11 RECOVERED OLD 1/2" IR.ROD IN TILE AS CALLED FOR IN L.W.JUNE SURV OF S-32, DATED DEC.31, 1912-JAN.1-3, 1913; CO SURVS REC (FIELD BK) NO.9, PGS.154-155, IN GRN FILE CAB DRW @ REG OF DEEDS. FD REMAINS (@ GRD.LEVEL) OF ONE L.W.J.WIT.STUMP.


D-11 REC OLD 1/2" IR.ROD IN 3" TILE AS CALLED FOR IN L.W.JUNE SURV OF S-32, DATED DEC.31, 1912-JAN 1-3 1913; CO SURVS REC (FIELD BOOK) NO.9, PGS 154-155, IN GRN FILE CAB.DRW @ REG OF DEEDS.SET CED POST W/LOC TAG ON E 1/4 N-S TRAIL, S88°33'W, 696'.FD.BOTH L.W.JUNE PINE WIT.STUMP REMAINS @ GRD LEVEL W/A FEW ROOT STUBS STICKING UP. COR FALLS IN OLD E-W FN REMAINS (B-W ON GRD).

E-11 FD & ACCEPTED 1/2" ROD W/RLS CAP, FOR NE COR OF S-32. FITS 2 W. BYL (RLS #23502) WITS (ASPEN & R.PINE) & 2 OF HIS ASPEN WITS (NOW STUMPS).

1 DROVE 5/8" X 34" REROD FOR NE COR OF NW 1/4 OF S-32.

C. Description of monument for corner and accessories established to perpetuate locating the position of the corner:

C-11		D-11		E-11	
FD OLD 1/2" X 50" IR ROD IN 2" 3"X12" VIT TILE FILLED W/CINDERS; ADDED CED POST W/LOC TAG.		FD OLD 1/2" IR ROD IN 3" VIT TILE; ADDED CED POST W/LOC TAG.		FD 1/2" REROD W/RLS CAP IN N-S BIT SURFACE ROAD	
12" SOFT MAPLE	S88°E 40.4	2" SOFT MAPLE	N40°W 11.6'	8" R.PINE	S60°E 62.13'
4" W PINE	S73°E 21.3'	6" SOFT MAPLE	N65°E 29.5'	5" W.PINE	S30°W 60.09'
3" W BIRCH	S50°E 18.0'	1" SOFT MAPLE	S55°E 23.6'	CTR 4"X4"	N50°W 43.08'
18" SOFT MAPLE	S20°E 45.2	5" SOFT MAPLE IN	S25°W 60.8'	W/LOC TAG	
E EDGE LAKE	DUE W 62±4'	CLUMP 3		SW COR	N40°E 75.9'
		W EDGE WSP.	DUE E 35±7'	CONC BLK	
				HSE FDN.	
				CTR N-S BIT	ADJ DUE W. 2'
				CTR GR RD	E DUE S. 11'
				SET CED POST	DUE DUE W. 33'
				W/LOC TAG	

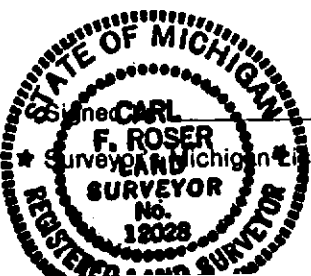

Carl F. Roser 02/10/88 Date

12028