

SURVEY & REMONUMENTATION

APR 28 1995

COMMISSION

LAND CORNER RECORDATION CERTIFICATE Filing Requirement of Act 74, Mich. P.A. 1970

RATIFIED BY PEER GROUP
PA 345 OF 1990
MONROE COUNTY, MICHIGAN

date: 11/8/1993

County Rep.: [Signature]
For corners in

MONROE

(County)

Located In:
BEDFORD TWP.

Corner Code ##

- | | | |
|------------------------------------|---|-----|
| 1. Public Land Survey | T <u>8</u> S <u>R</u> <u>7</u> E | B-3 |
| | T <u> </u> R <u> </u> | |
| | T <u> </u> R <u> </u> | |
| | T <u> </u> R <u> </u> | |
| 2. Property Controlling in Section | S <u> </u> T <u> </u> R <u> </u> | |
| | S <u> </u> T <u> </u> R <u> </u> | |
| 3. Miscellaneous Property in Sec. | S <u> </u> T <u> </u> R <u> </u> | |
| | S <u> </u> T <u> </u> R <u> </u> | |

4. Lot No. , Recorded Plat

5. Private Claims

MONROE COUNTY REMONUMENTATION PROGRAM Peer Group
approved corner on 11/08/1993 per Act 345 of 1990.

G.B. WARNKE, JR. in a field survey on 12/19, 19 94,
do hereby certify that under requirements of P.A. 74, Michigan P.A. of 1970, the corner points mentioned in lines 1 and 2 above were in conformance with regulations and rules therefore as required in the current manual of survey instructions of the United States Department of the Interior, Bureau of Land Management or by a decree of a Court of Law and/or that the corner points mentioned in lines 3, 4 and 5 above were in conformance with the rules of the Michigan Board of Land Surveyors or by a Decree of a Court of Law; established, re-established, monumented, re-monumented, recovered, found as expressed below:

NOTE: Not more than 4 corners, all in the same town and range, may be recorded on this certificate.

A. Description of original monument and accessories and/or subsequent restoration:


B-3, T8S, R7E, 1/4 Corner Between Sections 6 & 7
(On Samaria Road)

G.L.O. Surveyor Joseph Wampler set 1/4 section post. Witnesses: W. Oak 14 inch N.21°E. 70 links, W. Oak 19 inch N.82°W. 46 links. / Old book notes stake or stone in 1894? / M.R. Fleck in June of 1950 found an iron pipe. / A.J. Marino in February of 1953 found an iron pipe. / George B. Warnke in March of 1974 dug and found an iron pipe. In August of 1978, he excavated area again and no further evidence was found. / January of 1978, L.C.R.C., Liber 2, Page 120, notes iron pipe. / This corner has been used extensively since 1972 without interruption.

B. Description of corner evidence found and/or method applied in restoring or reestablishing corner:

B-3 - On 10/26/1993, set 1 inch x 36 inch pipe in replacement of found railroad spike being 2 inches deep over iron pipe and witnessed below. 12/19/1994, set brass remonumentation cap on 1 inch x 36 inch iron pipe inside set monument box.

	A	B	C	D	E	F	G	H	I	J	K	L	M
2	6		5		4		3		2		1		
3													
4	7		8		9		10		11		12		
5													
6	18		17		16		15		14		13		
7													
8	19		20		21		22		23		24		
9													
10	30		29		28		27		26		25		
11													
12	31		32		33		34		35		36		
13													

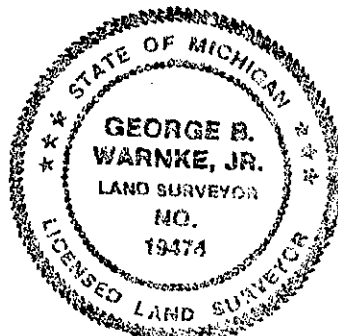

C. Description of monument for corner and accessories established to perpetuate locating the position of the corner:

B-3 - Set 1 inch x 36 inch pipe and is accepted as the best available evidence of the position of the original corner and witnesses:

North 02° West 33.03' found nail/aluminum shiner in west face of utility pole
South 04° West 61.77' found nail/aluminum shiner in west face of electric pole
South 16° East 135.87' northwest corner of brick house No. 3599
South 65° East 139.06' set nail/shiner in north face of telephone pole
1.5' north of centerline of Samaria Road asphalt pavement

12/19/1994, Set brass remonumentation cap on 1 inch x 36 inch iron pipe in monument box.

igned by

[Signature]
19474

Date 12/19/1994

urveyor's Michigan License No.