

SURVEY &
REMONUMENTATION

MONTCALM COUNTY REMONUMENTATION PROGRAM

AUG 3 1 1994 Corner approved by Peer Group on _____, 1994

COMMISSION

LAND CORNER RECORDATION CERTIFICATE

Filing Requirement of Act 74, Mich. P.A. 1970

STATE OF MICHIGAN
MONTCALM COUNTY
RECORDED

17 AUG 94 3:39 P.M.

VIRGINIA L. KNEPPER
REGISTER OF DEEDS

For corners in

Montcalm
(County)

Located In:

Corner Code #

1. Public Land Survey Sec 9 T 12 R 5 E-3, NW Corner
T _____ R _____
T _____ R _____
T _____ R _____
2. Property Controlling S _____ T _____ R _____
in Section S _____ T _____ R _____
3. Miscellaneous S _____ T _____ R _____
Property in Sec. S _____ T _____ R _____

4. Lot No. _____ Recorded Plat _____
5. Private Claims _____

I, William Tingley a field survey on June 30, 1994,
do hereby certify that under requirements of P.A. 74, Michigan P.A. of 1970, the corner points mentioned
in lines 1 and 2 above were in conformance with regulations and rules therefore as required in the
current manual of survey instructions of the United States Department of the Interior, Bureau of Land
Management or by a decree of a Court of Law and/or that the corner points mentioned in lines 3, 4 and 5
above were in conformance with the rules of the Michigan Board of Land Surveyors or by a Decree of a
Court of Law; established, re-established, monumented, re-monumented, recovered, found as
expressed below:

NOTE: Not more than 4 corners, all in the same town and range, may be recorded
on this certificate.

A. Description of original monument and accessories and/or subsequent restoration:
November 1838, Enoch Hammell, Deputy Surveyor, GLO Notes

Set Post

Pine 30" N40°W 19 links
Pine 76" N29°E 22 links

April, 1905, J.F. Daoust, County Surveyor, Book 4, page 124

Found stake at bottom and remains of U.S. Bearing Trees. Put down piece of plow shoe and axle skein.

New Bearing Tree.

Pine Stump 24" N25°W 62 links
Pine Stump 18" S39°W 51-1/2 links

November, 1905, J.F. Daoust, County Surveyor, Book 3, Page 146.

Same as above.

1962, G.M. Stevenson, County Surveyor, from R.D. McNutt's Index Cards 12-5

Set Steel Pin (1")

Light Pole Southwest 40.3 feet
Corner Fence Post Northeast 20.7 feet

August 1974, David B. Whittier, No. 10070, Liber 1, Page 165 (LCRC)

Found 2 large nails in frost pin hole.

Concrete Nail and Flag in post, Northwest 23.43 feet
Nail and Flag southside Power Pole S85°W 41.57 feet

ACCEPTED BY THE MONTCALM COUNTY SURVEY PEER
GROUP AS THE OFFICIAL CORNER UNDER MICHIGAN
PUBLIC ACT 345 OF 1990 AT A MEETING HELD 29 July 94

William Tingley, PS, Chairman

Continued on back

B. Description of corner evidence found and/or method applied in restoring or reestablishing corner:

Excavated and Found axle skein

Found 1/2" Rerod and cap #18273 S89°W 6.63 feet
Found Nail Southside Twin 18" Maple East 34.93 feet
Found Nail & Tag Northside Power Pole S70°W 56.04 feet

C. Description of monument for corner and accessories established to perpetuate locating the position of the corner:

Set Remonumentation and Monument Box.

Northeast Corner Riser Box N45°W 56.30 feet
Found Nail Southside Twin 18" Maple East 34.93 feet
Rerod S89°W 6.63 feet
Industrial Nail & Tag Northside Power Pole S70°W 56.04 feet

This corner accepted as a careful and faithful perpetuation of the position of the original corner

Signed by

William Tingley


Date

29 July 94

Surveyor's Michigan License No. 30104

FORM APPROVED BY MICHIGAN STATE BOARD OF LAND SURVEYORS, JAN. 28, 19

REVISED MAY 14, 197
REVISED JAN., 198
RD PROCESSING MARCH, 199

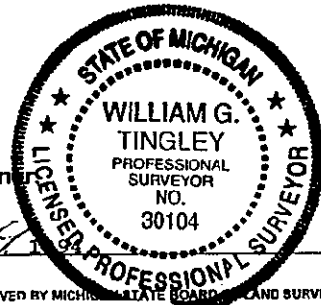

A. Continued from front (E-3, 12-5)

April, 1981, Thomas J. Mueller, No. 25861, Liber 540, Page 1270
Found Mears Engineering Inc. Iron
Scaffold Nail & Disc in Power Pole Southwest 49.48 feet
Cable Box southeast corner Northwest 52.45 feet
Nail and Cap in Clump Maple East 42.40 feet
April, 1981, Thomas J. Mueller, No. 25861, Liber 1, Page 554 (LCRC)
Same as above.

LIBER 3 PAGE 123

January 1991, W.G. Tingley, No. 30104
Iron and Cap, Herbert Fluharty, #18223
Nail in Power Pole S70°W 49.66 feet
Riser Box Southeast Corner N65°W 52.50 feet
Six Leg Double Arrow Sign East 27.42 feet