

# SURVEY & REMONUMENTATION

MAR 9 9 1999

STATE OF MICHIGAN  
COUNTY OF MUSKEGON  
RECEIVED FOR RECORD

1998 DEC 29 PM 4: 25

## LAND CORNER RECORDATION CERTIFICATE Filing Requirement of Act 74, Mich. P.A. 1970

### SECTION

For corners in

Muskegon  
(County)

Located in:

Corner Code #

1. Public Land Survey

T 9 N R 14 W G-11  
T    R     
T    R     
T    R     
S    T    R     
S    T    R     
S    T    R     
S    T    R   

2. Property Controlling  
in Section

3. Miscellaneous  
Property in Sec.

4. Lot No.           , Recorded Plat             
5. Private Claims           

*Carrie Carter*  
REGISTER OF DEEDS

LIBER 2189 PAGE 827

Register of Deeds Stamp & File Number

I, Ralph W VanRiper, in a field survey on Oct 21, 1998 do hereby state that under requirements of P.A. 74, Michigan P.A. of 1970, the corner points mentioned in lines 1 and 2 above were in conformance with regulations and rules therefore as required in the current manual of survey instructions of the United States Department of the Interior, Bureau of Land Management or by a decree of a Court of Law and/or that the corner points mentioned in lines 3, 4 and 5 above were in conformance with the rules of the Michigan Board of Land Surveyors or by a Decree of a Court of Law; established, re-established, monumented, recovered, found as expressed below:

NOTE: Not more than 2 corners, all in the same town and range, may be recorded on this certificate.

	A	B	C	D	E	F	G	H	I	J	K	L	M
1													
2	6		5		4		3		2		1		
3													
4	7		8		9		10		11		12		
5													
6	18		17		16		15		14		13		
7													
8	19		20		21		22		23		24		
9													
10	30		29		28		27		26		25		
11													
12	31		32		33		34		35		36		
13													

### A. Description of original monument and accessories and/or subsequent restoration:

Section Corner common to Sections 27, 28, 33 and 34, T 9 N, R 14 W  
Post set by GLO Surveyors in 1837 : Beech 6" N48°W 8L & Beech 6" S89°W 37L

MCRC 1950's Witness Map shows nothing at this corner

Current MCRC Witness Map shows : Set 1/2 rod CPE - W 2' + Fence - N 57' + CL Trail - S 57' + Trail - S 28.60' 6" Tril Pine - S 31.31' 6" Pine - SE 18.82' 6" Pine - LCRC, L-1112, P-723 by D W Bonnema in 1977

### B. Description of corner evidence found and/or method applied in restoring or reestablishing corner:


Found 1/2 " Rod, Accepted Corner based on Historical Usage and Documentation

POSITION OF SAID  
RECORDED CORNER  
REVIEWED & RATIFIED  
BY MUSKEGON COUNTY  
PEER GROUP IN ACCORDANCE  
WITH P.A. 345, OF 1990

### C. Description of monument for corner and accessories established to perpetuate locating the position of the corner:

Set 2 3/4 Cast Iron Monument with County Survey Cap

N 55° E 76.18' Set Spike on S side of 4" Pine  
S 64° E 56.01' Set Spike in S side of 8" Twin Cherry  
S 14° E 31.97' Set Spike in W side of 10" Pine  
S 16° W 43.59' Found Spike in W side of 7" Pine  
S 62° W 28.60' Found Spike in SE side of 8" Triple Pine  
N 47° W 43.84' Set "PK" Nail in NE side of Power Pole

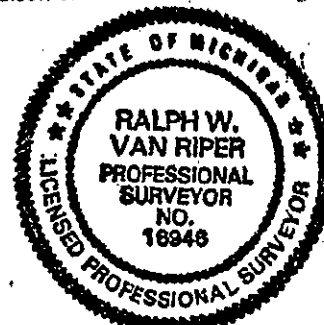

Signed by

*Ralph W. Van Riper*

Date

Oct 21, 1998

Surveyor's Michigan License No.

16946

A2004