

SURVEY & REMONUMENTATION

A1871 Pg. 641

A1749

APR 04 1996

COMMISSION

LAND CORNER RECORDATION CERTIFICATE
Filing Requirement of Act 74, Mich. P.A. 1970

For corners in

Muskegon
(County)

Located In:

Corner Code #

1. Public Land Survey T 9N R 15W
T _____ R _____
T _____ R _____
T _____ R _____
2. Property Controlling S _____ T _____
in Section S _____ T _____
3. Miscellaneous S _____ T _____
Property in Sec. S _____ T _____

A-6 **SURVEY &
REMONUMENTATION**
APR 04 1996
COMMISSION

R.O.D.
Also
INDEX
UNDER
M-6
T9N R16W

4. Lot No. _____, Recorded Plat _____
5. Private Claims _____

I, Stephen V. Vallier, P.S., in a field survey on December 8, 19 95
do hereby certify that under requirements of P.A. 74, Michigan P.A. of 1970, the corner points mentioned
in lines 1 and 2 above were in conformance with regulations and rules therefore as required in the
current manual of survey instructions of the United States Department of the Interior, Bureau of Land
Management or by a decree of a Court of Law and/or that the corner points mentioned in lines 3, 4 and 5
above were in conformance with the rules of the Michigan Board of Land Surveyors or by a Decree of a
Court of Law; established, re-established, monumented, re-monumented, recovered, found as
expressed below:

NOTE: Not more than 4 corners, all in the same town and range, may be recorded
on this certificate.

A. Description of original monument and accessories and/or subsequent restoration:

1837 GLO set corner	S 63 deg. W	20 Links	8" Birch
	N 56 deg. W	22 Links	24" Maple
1950's M.C.R.C. - no monument not	NNE	58.50'	6" Pine
	NE	50.49'	6" Pine
	SE	41.00'	18" Maple

(see Exhibit "A")

A	B	C	D	E	F	G	H	I	J	K	L	M
2	6	5	4	3	2							
3												
4	7	8	9	10	11	12						
5												
6	18	17	16	15	14	13						
7												
8	19	20	21	22	23	24						
9												
10	30	29	28	27	26	25						
11												
12	31	32	33	34	35	36						
13												

STATE OF MICHIGAN
COUNTY OF MUSKEGON
RECORDED
1995 DEC 18 PM 4:18
VALLIER, STEPHEN
SURVEYOR

3. Description of corner evidence found and/or method applied in restoring or reestablishing corner:

Found 4" x 30" Cast Iron Monument with County Survey Cap.

N 40 deg. E	55.14'	12" Pine
N 80 deg. E	32.14'	Light Pole
S 50 deg. E	41.10'	32" Maple


POSITION OF SAID
RECORDED CORNER
REVIEWED & RAFFIED
BY MUSKEGON COUNTY
PEER GROUP IN ACCORDANCE
WITH P.A. 345, OF 1990

Nov 13, 1995

Description of monument for corner and accessories established to perpetuate locating the position of the corner:

Found 4" x 30" Cast Iron Monument with County Survey Cap.

N 40 deg. E	55.14'	12" Pine
N 80 deg. E	32.14'	Light Pole
S 50 deg. E	41.10'	32" Maple
S 70 deg. W	41.35'	Step sign
S 15 deg. E	84.75'	14" Jack Pine

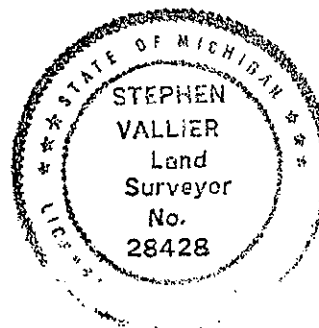

red by Stephen Vallier Date 12/15/95
veyor's Michigan License No. 28428