

LAND CORNER RECORDATION CERTIFICATE

Filing Requirement of Act 74, Mich. P.A. 1970

For corners in
Muskegon County

Located in:

Corner Code #

1. Public Land Survey

T 11N R 15W

E-2

SURVEY &
REMONUMENTATION2. Property Controlling
in Section

S

T

3. Miscellaneous
Property in Sec.

S

T

4. Lot No. _____, Recorded Plat

5. Private Claims _____

MAR 21 1997

COMMISSION

Register of Deeds Stamp & File Number

	A	B	C	D	E	F	G	H	I	J	K	L	M
2	6	5	4	3	2	1							
3													
4	7	8	9	10	11	12							
5													
6	18	17	16	15	14	13							
7													
8	19	20	21	22	23	24							
9													
10	30	29	28	27	26	25							
11													
12	31	32	33	34	35	36							
13													

I, Donald G. Sandel, in a field survey on Nov. 17, 1993 hereby certify that under requirements of P.A. 74, Michigan P.A. of 1970, the corner points mentioned in lines 1 and 2 above were in conformance with regulations and rules therefore as required in the current manual of survey instructions of the United States Department of the Interior, Bureau of Land Management or by a decree of a Court of Law and/or that the corner points mentioned in lines 3, 4 and 5 above were in conformance with the rules of the Michigan Board of Land Surveyors or by a Decree of a Court of Law; established, re-established, monumented, re-monumented, recovered, found as expressed below:

NOTE: Not more than 4 corners, all in the same town and range, may be recorded on this certificate.

A. Description of original monument and accessories and/or subsequent restoration:

- (1) GLO set quarter section post June 16, 1837
W. Oak 6" N57 degrees E 0.21 chains
W. Oak 9" N13 degrees W 0.22 chains

(2) No MCRC (1950's) witnesses on record for this corner (1950) or other information to our knowledge.

B. Description of corner evidence found and/or method applied in restoring or reestablishing corner:

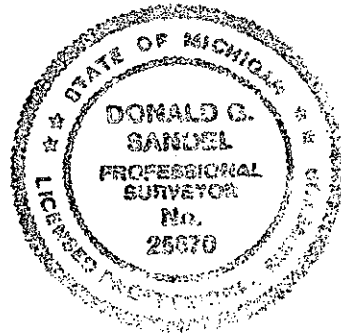
- (1) Set corner as lost 1/4 post by single proportion method - no occupation.

(2) Historical usage, documentation, and evidence of corner location reviewed and ratified by the Muskegon County Peer Group, November 16, 1993.

THIS CERTIFICATE SUPERSEDES LIBER 1744, PAGE 216
WHICH WAS RECORDED WITH ERROR.

C. Description of monument for corner and accessories established to perpetuate locating the position of the corner:

Set 4" X 20" Cast Iron "County Survey" monument witnessed as follows:
S09°E set nail E side with 3 blaze marks, 8" Oak 33.37'
S37°W set nail NW side with 3 blaze marks, 10" Oak 20.23'
N34°W set nail S side with 3 blaze marks, 10" Oak 18.21'
N67°E set nail S side, 5" Pine, 14.21'
N86°W set nail S side, 14" W. Oak, 34.90'
S27°W set nail NE side 6" W. Oak, 44.92'

Signed by Donald G. Sandel
Surveyor's Michigan License No.

25870

Date

19 December 1996