

✓

MICHIGAN
DEPARTMENT OF CONSERVATION
FORESTRY DIVISION

LAND CORNER RECORD

T. 43. NR. 25. W. .

----- Marquette ----- COUNTY

DESCRIPTION OF CORNER Section corner common to sections 4, 5, 8, 9. -----

DESCRIPTION OF CORNER MONUMENT 1" pipe with 4" brass cap. -----

WITNESSES TO CORNER 10" Spruce - N 1 E - 35 Links -----

5" Balsam - S 52 E - 37 Links -----


9" Spruce - N 78 W - 74 Links -----

DESCRIPTION IN DETAIL AS TO HOW CORNER WAS LOCATED AND IDENTIFIED OR
RESTORED.

Corner was found, and pointed out to me by Arne Metsa, District
Forester, of Gwinn. Two original B.T.'s still in place; both in very poor
condition.

Corner was placed and witnessed October 10, 1950.

SURVEYORS SEAL

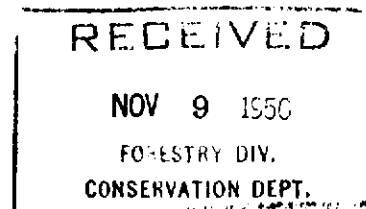

SIGNED Dean C. Seider DATE 11/1/50
REGISTERED LAND SURVEYOR