

RECORDED

1993

COMMISSION

JOB NUMBER: 93300
SHEET NO. : 1-409
For corners in

LAND CORNER RECORDATION CERTIFICATE
Filing Requirement of Act 74, Mich. P.A. 1970

RECEIVED FOR RECORDING
MARQUETTE COUNTY
MICHIGAN
333 DEC 29 AM 10:35

Located In: MARQUETTE (County) Corner Code ##

1. Public Land Survey	T 45N R 25W	MC M-8/9
	T 45N R 24W	MC A-8/9 ✓
	T R	
	T R	#1
2. Property Controlling in Section	S T R	
	S T R	
3. Miscellaneous Property in Sec.	S T R	
	S T R	

LIBER 1 PAGE 25
Register of Deeds Stamp & File Number

4. Lot No. , Recorded Plat
5. Private Claims

I, GERALD W. CARLSON, in a field survey on Thursday, December 23, 1993, do hereby certify that under requirements of P.A. 74, Michigan P.A. of 1970, the corner points mentioned in lines 1 and 2 above were in conformance with regulations and rules therefore as required in the current manual of survey instructions of the United States Department of the Interior, Bureau of Land Management or by a decree of a Court of Law and/or that the corner points mentioned in lines 3, 4 and 5 above were in conformance with the rules of the Michigan Board of Land Surveyors or by a Decree of a Court of Law; established, re-established, monumented, re-monumented, recovered, found as expressed below:

NOTE: Not more than 4 corners, all in the same town and range, may be recorded on this certificate.

	A	B	C	D	E	F	G	H	I	J	K	L	M
2	6	5	4	3	2	1							
3													
4	7	8	9	10	11	12							
5													
6	18	17	16	15	14	13							
7													
8	19	20	21	22	23	24							
9													
10	30	29	28	27	26	25							
11													
12	31	32	33	34	35	36							
13													

A. Description of original monument and accessories and/or subsequent restoration:

MC M-9: Meander Corner North of the Section Corner common to Sections 24 & 25, T45N-R25W and Sections 19 & 30, T45N-R24W. 1844: William A. Burt's original survey notes described the corner monument as a wood post referenced by:
7" Spruce Pine West 4, 41
(North shore of Little Lake)


No date - CCI Company map of Little Lake and Mehl Lake indicates an iron pipe on the North shore of Little Lake at this corner position.
1985 - C.F. Clark found a 1" iron pin at the shoreline witnessed by RLS No. 20711. Referenced by:
Nails/Tags (RLS No. 20711) in: Set Nails in:
15" Jack Pine N70W 12.9 ft. 10" Poplar S60W 20.4'
14" Jack Pine North 15.6 ft. 3" W. Pine 12.4'
(Meas. to base leaning pin) LSRC, PG. 56

B. Description of corner evidence found and/or method applied in restoring or reestablishing corner:

1993 - Found 5/8 iron on North shore of Little Lake. This location proved impractical to set a marker. Set a Marquette County Survey Monument 4.0 ft. North of found 5/8" iron on line with the found 5/8" iron and the East 1/4 corner of Section 24, T45N-R25W. Peer group ratification 12-13-93.

C. Description of monument for corner and accessories established to perpetuate locating the position of the corner:

1993 - Set a 2 1/8" diameter aluminum pipe capped with a 3 1/4" diameter aluminum tablet Marquette County Survey Monument stamped to identify the corner referenced by nails in:
12" Jack Pine N06E 11.61 ft.
5" White Pine N69E 9.79 ft.
13" Jack Pine S51W 81.75 ft.
5" White Pine N44W 28.71 ft.
Monument 0.4 ft. above ground, 4 ft. North of waters edge of Little Lake.
Bk. 6, Pg. 8

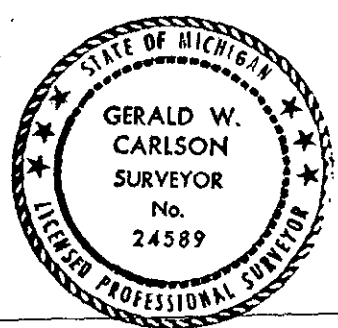

Signed by Gerald W. Carlson Date 12-28-93

Surveyor's Michigan License No. 24589