

**LAND CORNER RECORDATION CERTIFICATE**  
 Filing Requirement of Act 74, Mich. P.A. 1970 as Amended

For corners in

<u>Marquette</u> (County)	Located In:	Corner Code #
1. Public Land Survey	T 45N R 30W	MC G11-G12 N
	T 45N R 30W	MC G11-G12 S
2. Property Controlling in Section	T _____ R _____	_____
	S _____ T _____ R _____	_____
	S _____ T _____ R _____	_____
3. Miscellaneous Property in Sec.	S _____ T _____ R _____	_____
	S _____ T _____ R _____	_____
4. Lot No. _____, Recorded Plat _____		
5. Private Claims _____		

Register of Deeds Stamp & File Number

	A	B	C	D	E	F	G	H	I	J	K	L	M
1													
2	6		5		4		3		2		1		
3													
4	7		8		9		10		11		12		
5													
6	18		17		16		15		14		13		
8	19		20		21		22		23		24		
9													
10	30		29		28		27		26		25		
11													
12	31		32		33		34		35		36		
13													

I, Stephan J. Szyszkoski, in a field survey on MC N 06/19/2012 do hereby state that under requirements of P.A. 74, Michigan P.A. of 1970, the corner points mentioned in lines 1 and 2 above were in conformance with regulations and rules therefore as required in the current manual of survey instructions of the United States Department of the Interior, Bureau of Land Management or by a decree of a Court of Law and /or that the corner points mentioned in lines 3, 4 and 5 above were in conformance with the rules of the Michigan Board of Land Surveyors or by a Decree of a Court of Law; established, re-established, monumented, recovered, found as expressed below:

NOTE: Not more than 2 corners, all in the same town and range, may be recorded on this certificate.

A. Description of original monument and accessories and/or subsequent restoration:

(MC G11-G12 N) Meander corner on the north shore of Harris Lake, on the line between Sections 33 and 34. 1848 - Established by Wells Burt, Deputy Surveyor, on the Section line and 1.70 chains south of Section corner G11. Set Tamarack post. Spruce 4" N35W 8 links, Tamarack 6" N29E 44 links. Found no subsequent record.

(MC G11-G12 S) Meander corner on the south shore of Harris Lake, on the line between Sections 33 and 34. 1848 - Established by Wells Burt, Deputy Surveyor, on the Section line 69.61 chains north of Section corner G13 and 10.39 chains south of Section corner G11. Set Tamarack post. Tamarack 8" S40W 28 links, Spruce 4" S89E 19 links. Found no subsequent record.

B. Description of corner evidence found and/or method applied in restoring or reestablishing corner:

(MC G11-G12 N) The original post and accessories were not recovered. Found no acceptable evidence of the position of the original corner on the ground. Reestablished the position for the corner by single proportionate measurement to the original record, on the Section line between Section corners 111.97' north (GLO 112.2') and 5156.46' south (GLO 5167.80'). The position for the corner falls on the shoreline of Harris Lake in unstable soil and was not monumented. Established and monumented a WITNESS CORNER on the Section line, 15.00' north of the corner position.

(MC G11-G12 S) The original post and accessories were not recovered. Found no acceptable evidence of the position of the original corner on the ground. Reestablished the position for the corner by single proportionate measurement to the original record, on the Section line between Section corners G11 684.24' north (GLO 685.74') and G13 4584.19' south (GLO 4594.26'). The position for the corner falls on the south shore of Harris lake.


C. Description of monument for corner and accessories established to perpetuate locating the position of the corner:

(MC G11-G12 N) Set 1"IDx32" I.pipe with 4" alum. MDNR cap for a WITNESS CORNER 15.00' north of the corner position.  
 Set measuring nail with MDNR tag in the side of:  
 4" Tamarack N19E 12.3' mrkd "WC BT"  
 3" B.Spruce S87E 7.0' do  
 4" Tamarack S29E 15.2' do  
 7" Tamarack S17W 14.9' do  
 Set sq'd Cedar post adjacent.  
 Bearings are magnetic.

(MC G11-G12 S) Set 1"IDx40" I.pipe with 4" alum. MDNR cap. Set measuring nail with MDNR tag in the side of:  
 3" Tamarack N32E 13.8' mrkd "MC NBT"  
 6" B.Spruce S46E 6.0' do  
 7" B.Spruce S23W 19.2' do  
 4" Tamarack N80W 19.5' do  
 Set sq'd Cedar post adjacent.  
 Bearings are magnetic.

Signed by Stephan J. Szyszkoski  
 Surveyor's Michigan License No. 33986

Date 09/06/2012

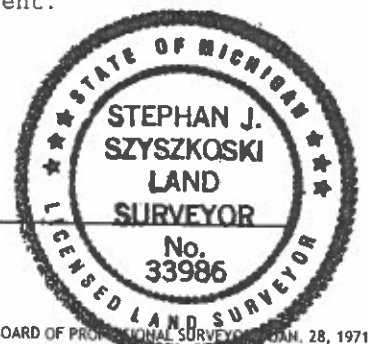

For the Michigan Department of Natural Resources, Forest Resources Division