

LAND CORNER RECORDATION CERTIFICATE  
Filing Requirement of Act 74, Mich. P.A. 1970

For corners in

Marquette  
(County)

Located In:

Corner Code #

1. Public Land Survey

T\_\_\_ R\_\_\_  
T\_\_\_ R\_\_\_  
T\_\_\_ R\_\_\_  
T\_\_\_ R\_\_\_

2. Property Controlling  
in Section

S 27 T 46W R 28W 2  
S 27 T 46W R 28W 4

3. Miscellaneous  
Property in Sec.

S\_\_\_ T\_\_\_ R\_\_\_  
S\_\_\_ T\_\_\_ R\_\_\_

Register of Deeds Stamp & File Number

4. Lot No. \_\_\_\_\_, Recorded Plat \_\_\_\_\_

5. Private Claims \_\_\_\_\_

4 Oct 14 1997  
2 Sep 30 1997

I, Paul R. Bressette, in a field survey on \_\_\_\_\_, 19\_\_\_\_ do hereby state that under requirements of P.A. 74, Michigan P.A. of 1970, the corner points mentioned in lines 1 and 2 above were in conformance with regulations and rules therefore as required in the current manual of survey instructions of the United States Department of the Interior, Bureau of Land Management or by a decree of a Court of Law and/or that the corner points mentioned in lines 3, 4 and 5 above were in conformance with the rules of the Michigan Board of Land Surveyors or by a Decree of a Court of Law; established, re-established, monumented, recovered, found as expressed below:

NOTE: Not more than 2 corners, all in the same town and range, may be recorded on this certificate.

	A	B	C	D	E	F	G	H	I	J	K	L	M
1													
2	6			5		4		3		2		1	
3													
4	7			8		9		10		11		12	
5													
6	18			17		16		15		14		13	
7													
8	19			20		21		22		23		24	
9													
10	30			29		28		27		26		25	
11													
12	31			32		33		34		35		36	
13													

A. Description of original monument and accessories and/or subsequent restoration:


- 2) East One-sixteenth corner common to Sections 22 and 27. Not set in original survey, no evidence of subsequent establishment.  
4) Northwest 1/16 corner of Section 27. Not set in original survey, no evidence of subsequent establishment.

B. Description of corner evidence found and/or method applied in restoring or reestablishing corner:

- 2) Corner position established mid-point and on-line between the Northeast and North Quarter corners of Section 27.  
4) Corner position established at the intersection of the North and West One-sixteenth lines of Section 27.

C. Description of monument for corner and accessories established to perpetuate locating the position of the corner:

- 2) DNR monument  
8" J.Pine N58E 12.2' (1/16S,BT)  
8" J.Pine S54E 37.5' (1/16S,BT)  
0" J.Pine S46W 32.7' (1/16S,BT)  
8" J.Pine N77W 59.7' (1/16S,BT)  
11 trees are blazed, scribed and painted. Measurements are to nail in side of tree, bearings are magnetic.
- (4) DNR monument  
13" J.Pine N20E 65.4' (1/16S,BT)  
13" J.Pine N73E 32.8' (1/16S,BT)  
12" J.Pine S56E 51.4' (1/16S,BT)  
06" J.Pine S07E 38.35' (1/16S,BT)  
All trees are blazed, scribed and painted. Measurements are to nail in side of tree, bearings are magnetic.

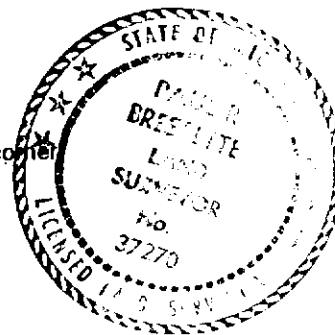

Signed by Paul R. Bressette  
Surveyor's Michigan License No. 37270

Date \_\_\_\_\_

For the Michigan Department of Natural Resources - Forest Management Division