

MARQUETTE COUNTY  
MICHIGAN  
RECEIVED FOR RECORD

1993 SEP 30 PM 4:39

LAND CORNER RECORDATION CERTIFICATE  
Filing Requirement of Act 74, Mich. P.A. 1970

*Robert A. Moulton*  
REGISTER OF DEEDS

For corners in

Marquette (County) Located In: Corner Code 77

1. Public Land Survey	T	46N	R	28W	G-2, II-1, II-3
	T		R		
	T		R		
	T		R		
2. Property Controlling in Section	S	3	T	46N R 28W	9
	S		T		
3. Miscellaneous Property in Sec.	S		T		
	S		T		
4. Lot No. _____, Recorded Plat					
5. Private Claims _____					

Libery 5 B,C; Page 391

Register of Deeds Stamp & File Number

I, Paul R. Bressette, in a field survey on September 21-22, 1993, do hereby certify that under requirements of P.A. 74, Michigan P.A. of 1970, the corner points mentioned in lines 1 and 2 above were in conformance with regulations and rules therefore as required in the current manual of survey instructions of the United States Department of the Interior, Bureau of Land Management or by a decree of a Court of Law and/or that the corner points mentioned in lines 3, 4 and 5 above were in conformance with the rules of the Michigan Board of Land Surveyors or by a Decree of a Court of Law; established, re-established, monumented, re-monumented, recovered, found as expressed below:

NOTE: Not more than 4 corners, all in the same town and range, may be recorded on this certificate.

	A	B	C	D	E	F	G	H	I	J	K	L	M
2	6		5				4	3		2			
3													
4	7		8				9	10		11		12	
5													
6	18		17				16	15		14		13	
7													
8	19		20				21	22		23		24	
9													
10	30		29				28	27		26		25	
11													
12	31		32				33	34		35		36	
13													

A. Description of original monument and accessories and/or subsequent restoration

- 3-2. Quarter corner common to Sections 3 and 4. 1960: Billy D. Buckler, RLS. Set 1" iron pipe with 4" brass cap witnessed by: 6" W. Birch N88E 32 links; 6" Aspen S30W 16 1/2 links.
- 1-1. Quarter corner common to Sections 3 and 34. 1958: Billy D. Buckler, RLS. Rewitnessed iron pin with 2" top. Found witnesses: 12" J. Pine S73W 80 1/2 links; R. Pine S63E 188 1/2 links. Established 9" J. Pine N03W 27 links. No diameter given for Red Pine.
- 1-3. Quarter corner common to Sections 3 and 10. 1958: Billy D. Buckler, RLS. Set 1" iron pipe with 4" brass cap witnessed by: 8" B. Spruce N72W 24 links; 12" J. Pine N63E 190 links.

9. East One-sixteenth corner of Section 3. Found 2" iron pipe set by landowner next to a hub.

B. Description of corner evidence found and/or method applied in restoring or reestablishing corner:


- 3-2. Found monument and W. Birch witness as described. Rewitnessed monument as found.
- 1-1. Found iron pin and witnesses as described. NW Jack Pine has blown over and SW Jack Pine is dead but standing. Rewitnessed monument as found.
- 1-3. Found monument and Jack Pine witness as described. Witness is dead but standing with both faces visible. Rewitnessed monument as found.
- 9. Rejected 2" iron pipe. Landowner claims to have assisted a surveyor in setting the hub and said they never went to the west quarter corner of the section. Pipe falls 23.3 feet west of calculated position. Corner position established mid-point and on-line between the Center Quarter and East Quarter corners of Section 3.

C. Description of monument for corner and accessories established to perpetuate locating the position of the corner.

1-2. DNR mon (brass cap)	H-1. I. Pin w/ 2" top	H-3. DNR mon (brass cap)	9. DNR monument
*11" W. Birch S85E 21.1'	8" R. Pine N10E 101.65'	6" Aspen N83E 34.25'	7" Cherry N22E 33.8'
6" Aspen S14E 14.25'	*22" R. Pine S55E 124.4'	3" Spruce S28E 48.0'	36" J. Pine N88E 43.65'
6" Aspen S61W 16.5'	P. Pole S18W 38.35'	10" Spruce S10W 64.65'	10" Balsam S22E 12.75'
6" Aspen N25W 16.4'	6" J. Pine N71W 45.35'	5" Cherry N26W 51.2'	4" Balsam S20W 21.3'

\* old NBT

\* old NBT

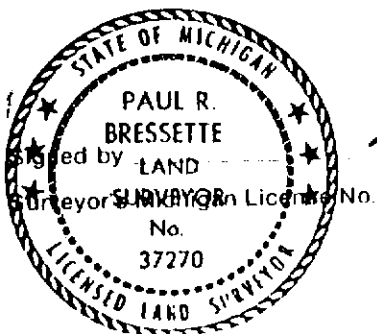

*Paul R. Bressette* Date 9-30-93  
37270