

JOB NUMBER: 95053
SHEET NO. : 1-624

APR 01 1996

COMMISSION

LAND CORNER RECORDATION CERTIFICATE
Filing Requirement of Act 74, Mich. P.A. 1970

MARQUETTE COUNTY
MICHIGAN
RECEIVED FOR RECORD

1995 DEC 27 AM 7:44

Patricia A. Moxley
REGISTER OF DEEDS

For corners in

MARQUETTE
(County)

Located In:

Corner Code #

1. Public Land Survey

T47N R25W

M-9

T47N R25W

A-9

2. Property Controlling
in Section

S

T

R

S

T

R

3. Miscellaneous

S

T

R

Property in Section

S

T

R

4. Lot No. , Recorded Plat

5. Private Claims

LIBER

1 PAGE 242

Register of Deeds Stamp & File Number

I, GERALD W. CARLSON, in a field survey on Tuesday, November 7, 1995

do hereby certify that under requirements of P.A. 74, Michigan P.A. of 1970, the corner points mentioned in lines 1 and 2 above were in conformance with regulations and rules therefore as required in the current manual of survey instructions of the United States Department of the Interior, Bureau of Land Management or by a decree of a Court of Law and/or that the corner points mentioned in lines 3, 4 and 5 above were in conformance with the rules of the Michigan Board of Professional Surveyors or by a Decree of a Court of Law; established, re-established, monumented, re-monumented, recovered, found as expressed below:

NOTE: Not more than 4 corners, all in the same town and range, may be recorded on this certificate.

A. Description of original monument and accessories and/or subsequent restoration:

M-9: Section Corner common to Sections 24 and 25, T47N-R25W unknown surveyor. Corner checked proportionally in all and Sections 19 and 30, T47N-R25W. 1844: William A. Burt's directions. No original evidence of corner found in burned original survey notes describe the corner monument as a wood over plains. Replaced corner with 1" pipe with 4" brass post referenced by: cap. Established reference:

10" Fir N82W, 19 1

.8" J. Pine S88E, 89.76'

12" W. Birch S22E, 30 1

1951: MCRC F.B. #651 (No page given) indicates the corner

1951: A Land Corner Record recorded by the Michigan Department of Conservation Forestry Division (Dean C. De La Mater

recorded above in Record of Surveys Book #1, Pg. 135.

RLS #05778), in Record of Surveys Book #1, Pg. 135, indicates a found 1" bar at corner location previously set by an

1989: The corner is indicated on an Easement Description

Map for Wisconsin Electric recorded by Sundberg, Carlson,

and Associates in L. 130, MR Pg. 756.

B. Description of corner evidence found and/or method applied in restoring or reestablishing corner:

1995: Found and rejected a 3/4" diameter iron rod, 3" above ground. Distance North is 2637.19', and Distance South is 2654.27'. This position was established using the D.N.R. 1951 survey notes indicating the D.N.R. chainage on their random line between the E-W Railroad spur and the C&NW main track that bears N38W +/- . The chainage on their random line between the tracks was re-created and the corner was set 40.26' East of this random line and 745.80' North of the Southerly Railroad Spur. The D.N.R. indicated that they found an iron at this position in 1951.

RATIFIED BY PEER GROUP
P.A. 345 OF 1990

Larry J. Bussone
DATE 11/13/95

C. Description of monument for corner and accessories established to perpetuate locating the position of the corner:

1995: Set a 2 3/8" O.D. aluminum pipe capped with a 3 1/4" aluminum tablet Marquette County Survey Monument, 0.20' above ground, and stamped to identify the corner. Referenced by duplex nails set in:

5" J. Pine N87E, 89.35'

21" J. Pine S01W, 171.61'


4" J. Pine S22W, 116.15'

8" J. Pine S33W, 84.32'

Green Steel Fence Post w/Yellow Survey Marker Sign North, 1.0'

Note: Bearing Trees were face and butt blazed, painted, with B.T. Tags affixed.

Bk. 9, pp. 53-54. Bk. 11, pp. 65-66.

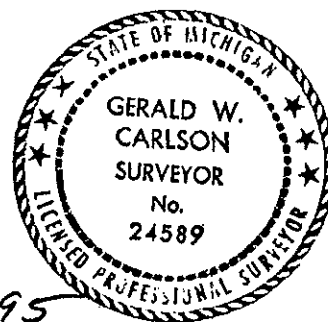

Signed by *Gerald W. Carlson*

Date 12-15-95

Surveyor's Michigan License No. 24589

FORM APPROVED BY MICHIGAN STATE BOARD OF PROFESSIONAL SURVEYORS. JAN. 28, 1971
REVISED MAY 14, 1975
REVISED JAN., 1983