

1993

## COMMISSION

JOB NUMBER: 93300

SHEET NO. : 1-352

For corners in

## LAND CORNER RECORDATION CERTIFICATE

Filing Requirement of Act 74, Mich. P.A. 1970

MARQUETTE  
(County)

Located In:

Corner Code #

## 1. Public Land Survey

T47N R24W

T47N R25W

T R

T R

2. Property Controlling  
in Section

S T R

S T R

3. Miscellaneous  
Property in Sec.

S T R

S T R

A-7

M-7

LIBER

1 PAGE

46

Register of Deeds Stamp &amp; File Number

## 4. Lot No. , Recorded Plat

## 5. Private Claims

I, GERALD W. CARLSON, in a field survey on Tuesday, December 14, 1993, do hereby certify that under requirements of P.A. 74, Michigan P.A. of 1970, the corner points mentioned in lines 1 and 2 above were in conformance with regulations and rules therelore as required in the current manual of survey instructions of the United States Department of the Interior, Bureau of Land Management or by a decree of a Court of Law and/or that the corner points mentioned in lines 3, 4 and 5 above were in conformance with the rules of the Michigan Board of Land Surveyors or by a Decree of a Court of Law; established, re-established, monumented, re-monumented, recovered, found as expressed below:

**NOTE: Not more than 4 corners, all in the same town and range, may be recorded on this certificate.**

## A. Description of original monument and accessories and/or subsequent restoration:

A-7: Section Corner common to Sections 18 and 19, T47N-R24W and Sections 13 and 24, T47N-R25W. 1844: William A. Burt's original survey notes describe the corner monument as a wood post referenced by:

7" Lynn S27W, 21 1

10" Sugar N28E, 29 1

1960 - Gregory Shadko reset the corner from tree witnesses by C.M. Cade 1936 referenced by:

12" Poplar SW 44.6 ft.

12" Maple North 30.0 ft.

Drove 6" spike on fence lines-East side Two Rod Road North in centerline Marquette County 480 County highway.

Engineer - Mr. Gray - chained to known corners.

North, South, West, & East. Reset this point. No mark left in road. (See reverse side)

## B. Description of corner evidence found and/or method applied in restoring or reestablishing corner:

1993 - Found square pin in centerline monument box in the East bound lane of County Road 480. Distances North and East check from prior 1983 survey and the distance North is 1.83 shorter than Shadko's 1960 measurement. The distance along the North/South quarter line of Section 18 from the South 1/4 corner to the center of Section set by Shadko in 1960 is 1.80' shorter than Shadko's

indicating that there was a similar error in both of his North/South lines. The East/West distances on the East/West 1/4 line was 0.04' shorter than Shadko and the East/West distance on the South section line from the South 1/4 corner to the SW corner was 0.61' shorter than Shadko. Left square pin in monument box as found. Square pin in monument box was believed to be reset by the Road Commission during construction of Co.Rd. 480. Peer group ratification 12-6-93.

## C. Description of monument for corner and accessories established to perpetuate locating the position of the corner:

1993 - Placed a 3 1/4" diameter aluminum tablet Marquette County Survey Monument over 1" square pin in Monument box.

1 ft. South of the centerline of County Road 480 referenced by nails in:

South post of "Welcome to Sands Twp." sign N66W 70.72 ft.

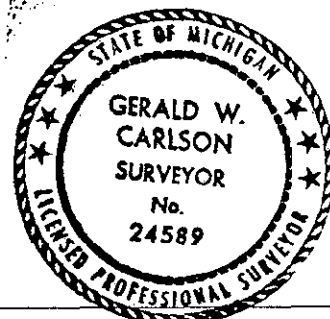
12" Maple N17W 116.98 ft.

10" Poplar N37E 83.07 ft.

Power Pole N10E 43.83 ft.

Monument 1.0 ft. below road surface.

Bk. 2, Pg. 152

Signed by Gerald W. CarlsonDate 12-23-93Surveyor's Michigan License No. 24589

Record No. 352

Part "A" Continued:

1979 - William Donnan, P.S. found a railroad tack (#58) 2 ft. South of the centerline of County Road 480 referenced by:

Power pole	N03E	55.30 ft.
10" Maple	N50W	53.77 ft.
10" Maple	S42W	38.42 ft.

L1 RC, Pg. 364