

SURVEY &
REMONUMENTATION

JOB NUMBER: 94030
SHEET NO. : 1-469
For corners in

APR 28 1995 LAND CORNER RECORDATION CERTIFICATE
Filing Requirement of Act 74, Mich. P.A. 1970

COMMISSION

MARQUETTE
(County)

Located In:

Corner Code ##

- 1. Public Land Survey T 47N R 24W E-5
2. Property Controlling in Section S T R
3. Miscellaneous S T R
Property in Sec. S T R

- 4. Lot No. , Recorded Plat
5. Private Claims

MARQUETTE COUNTY
MICHIGAN
RECEIVED FOR RECORD
1994 DEC 28 PM 5:55

Patricia A. Moulton
REGISTER OF DEEDS

LIBER 1 PAGE 140
Register of Deeds Stamp & File Number

I, GERALD W. CARLSON, in a field survey on Monday, December 12, 1994, do hereby certify that under requirements of P.A. 74, Michigan P.A. of 1970, the corner points mentioned in lines 1 and 2 above were in conformance with regulations and rules therefore as required in the current manual of survey instructions of the United States Department of the Interior, Bureau of Land Management or by a decree of a Court of Law and/or that the corner points mentioned in lines 3, 4 and 5 above were in conformance with the rules of the Michigan Board of Land Surveyors or by a Decree of a Court of Law; established, re-established, monumented, re-monumented, recovered, found as expressed below:


NOTE: Not more than 4 corners, all in the same town and range, may be recorded on this certificate.

A. Description of original monument and accessories and/or subsequent restoration:

E-5: SE Corner of Section 8, T47N-R24W. 1845: A.D. 6" Spruce S42W, 11.95' 14" Forked Cedar N67W, 22.06'
Sullivan's original subdivision survey notes describe the Distances North 2646.05', East 2625.42', South 2646.92',
corner monument as a wood post referenced by: West 2610.89'. L. 1, R.C., Pg. 314.
8" Spruce S51E, 15 L 7" Cedar N80E, 16 L 1982: Certificate of Survey recorded in Liber 001, Pg. 408
1979: LCRC filed by William Donnan RLS No. 17618 indicates by William F. Robey RLS No. 20711 indicates a found 5/8"
a set 5/8" by 36" re-rod with RLS cap #17618 by double proportion steel rod, 1" +/- high, referenced by tags in:
measure using four 1/4 Corners noted in Section A. 9" W. Spruce S45W, 11.90' 12" Cedar N63W, 22.05'
Referenced by Nail with RLS Tag in: 10" Cedar N40E, 11.85' 7" Cedar S72E, 12.34'
6" Cedar N34E, 11.85' 5" Cedar S72E, 12.37' (See reverse side).

B. Description of corner evidence found and/or method applied in restoring or reestablishing corner:

1994: Found and accepted 5/8" iron and cap No. 17618. Distance North is 2639.21' and distance East is 2623.67'.

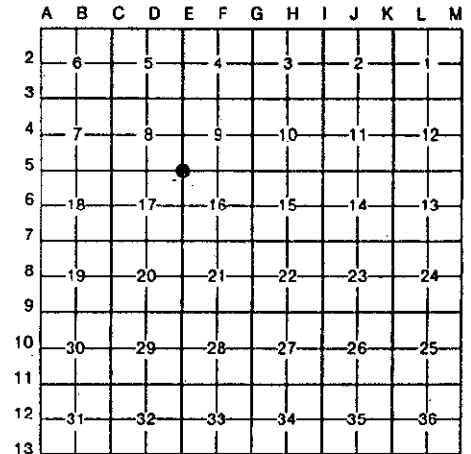

CERTIFIED BY PEER GROUP
P.A. 345 OF 1990

DATE Oct 31, 1994

C. Description of monument for corner and accessories established to perpetuate locating the position of the corner:

1994 - Replaced a 5/8" iron and cap #17618 with a 2 1/2" diameter aluminum pipe capped with a 3 1/4" diameter aluminum
tablet Marquette County Survey Monument stamped to identify the corner referenced by nails in:
17" Forked Cedar N65W 22.00 ft. Donnan NBT
7" Cedar S72E 12.34 ft. Donnan NBT
10" Spruce S43W 11.65 ft. Donnan NBT
9" Cedar N32E 11.98 ft. Donnan NBT
Steel sign post West 1.0 ft.
Monument is 0.20' above ground and is 88.50' East of creek.
Bk. 5, Pg. 105

Signed by Gerald W. Carlson
Surveyor's Michigan License No. 24589

Date 12-22-94



Record No. 469

Part "A" Continued:

1978: Certificate of Survey by William R. Donnan RLS No. 17618, recorded in Liber 1, Pg. 262, references the NW Corner of Section 16 as a set 5/8" rerod and cap-36" long:

6" Cedar	N34E,	11.85'
5" Cedar	S72E,	12.37'
6" Spruce	S42W,	11.95'
14" Forked Cedar	N67W,	22.06'

*R# 64.
Geo
Geo Rem*