

APR 1 1935

JOB NUMBER: 95053
SHEET NO. : 1-607

LAND CORNER RECORDATION CERTIFICATE
Filing Requirement of Act 74, Mich. P.A. 1970

REGISTERED
RECEIVED FOR RECORDS
MARQUETTE COUNTY
MICHIGAN
1995 DEC 27 AM 7:48

For corners in

Located In:	Corner Code #
MARQUETTE (County)	G-8
1. Public Land Survey	T ^{48N} R ^{25W}
	T _____ R _____
	T _____ R _____
	T _____ R _____
2. Property Controlling in Section	S _____ T _____ R _____
	S _____ T _____ R _____
3. Miscellaneous Property in Section	S _____ T _____ R _____
	S _____ T _____ R _____

LIBER 1 PAGE 28
Register of Deeds Stamp & File Number

4. Lot No. _____, Recorded Plat _____
5. Private Claims _____

I, GERALD W. CARLSON, in a field survey on Thursday, October 26, 1995, do hereby certify that under requirements of P.A. 74, Michigan P.A. of 1970, the corner points mentioned in lines 1 and 2 above were in conformance with regulations and rules therefore as required in the current manual of survey instructions of the United States Department of the Interior, Bureau of Land Management or by a decree of a Court of Law and/or that the corner points mentioned in lines 3, 4 and 5 above were in conformance with the rules of the Michigan Board of Professional Surveyors or by a Decree of a Court of Law; established, re-established, monumented, re-monumented, recovered, found as expressed below:

	A	B	C	D	E	F	G	H	I	J	K	L
2	6	5	4	3	2	1						
3												
4	7	8	9	10	11	12						
5												
6	18	17	16	15	14	13						
7												
8	19	20	21	22	23	24						
9												
10	30	29	28	27	26	25						
11												
12	31	32	33	34	35	36						
13												

NOTE: Not more than 4 corners, all in the same town and range, may be recorded on this certificate.

A. Description of original monument and accessories and/or subsequent restoration:

G-8: Quarter Corner common to Sections 21 and 22. 1846: William Ives' original survey notes describe the corner monument as a wood post referenced by:
 14" Hemlock S51E, 16 l
 6" Cedar N60W, 24 l
 1915: Charles Cummings, in Record of Surveys Pg. 155, indicates the corner as being on a fence line and 2640' North of the S.E. Corner of Section 21. No accessories given.
 1916: Charles Cummings, in Record of Surveys Pg. 157, indicates the corner as being 2640' North of the S.W. Corner of Section 21. No accessories given.

1930: The corner is indicated as a fence intersection in MCRC F.B. #401 (Page # unknown - 2/3 into book)
 No Date: The corner is indicated as a fence corner, N00-55'E, 2640' from the S.W. Corner Section 22, in MCRC F.B. #401 (Page # unknown - 3/4 into book).
 No Date: Corner is indicated as a fence intersection in MCRC F.B. #654 (Page unknown).
 1993: A Certificate of Survey, recorded by Glenn C. Van Neste in L. 002, SM Pg. 77, indicates (See Reverse Side)

B. Description of corner evidence found and/or method applied in restoring or reestablishing corner:

1995: Found and accepted a 5/8" iron with cap #27464, as recorded in L. 002, SM Pg. 77, at fence intersection from East and North/South. Fence intersection from West is 26.5' to the North of corner. Corner found on West slope of a ravine. Distance North is 2641.34', Distance South is 2648.43', and Distance East is 5208.74'.


RATIFIED BY PEER GROUP
P.A. 345 OF 1990

Larry J. Brunner
DATE Oct. 23, 1995

C. Description of monument for corner and accessories established to perpetuate locating the position of the corner:

1995: Replaced found 5/8" Iron with a 2 3/8" O.D. Aluminum Pipe capped with a 3 1/4" Aluminum Tablet Marquette County Survey Monument, 0.1' above ground, and stamped to identify the corner. Referenced by:

8" Triple Cedar N85W, 11.22' Van Neste Nail and Washer
 9" Cedar N20W, 11.11' Van Neste Nail and Washer
 7" Cedar N40E, 8.26' Van Neste Nail and Washer
 8" Cedar N21E, 17.70' New Wit.- Set Duplex Nail
 Green Steel Fence Post w/Yellow Survey Marker Sign Due North, 0.9'
 Note: Repainted existing face blazes, added butt blazes, and affixed B.T. Tags to trees.
 Bk. 10, Pg. 49.

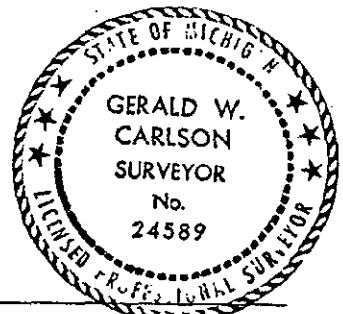

Signed by Gerald W. Carlson

Date 11-13-95

Surveyor's Michigan License No. 24589

Record No. 607:

Part A Continued:

a found 5/8" iron with cap #27464 S00-03-55E, 2641.35' from the N.W. Corner of Section 22.

Referenced by:

12" R. Pine	S36W,	82.61'
11" R. Pine	N82W,	109.62'
8" Spruce	S75W,	41.08'
7" R. Pine	S45E,	72.32'

*Ref
See
200
2017*