

SURVEY & REMONUMENTATION
APR 11 1995
COMMISSION

LAND CORNER RECORDATION CERTIFICATE

Filing Requirement of Act 74, Mich. P.A. 1970

For corners in
MENOMINEE
 (County)

Located In:

Corner Code #:

- 1. Public Land Survey T 32N R 28W MCH-3/I-3
- T _____ R _____
- T _____ R _____
- T _____ R _____
- 2. Property Controlling S _____ T _____ R _____
- in Section S _____ T _____ R _____
- 3. Miscellaneous S _____ T _____ R _____
- Property in Sec. S _____ T _____ R _____

- 4. Lot No. _____, Recorded Plat _____
- 5. Private Claims _____

I, William Lenca, in a field survey on Feb. 22, 19 94, do hereby certify that under requirements of P.A. 74, Michigan P.A. of 1970, the corner points mentioned in lines 1 and 2 above were in conformance with regulations and rules therefore as required in the current manual of survey instructions of the United States Department of the Interior, Bureau of Land Management or by a decree of a Court of Law and/or that the corner points mentioned in lines 3, 4 and 5 above were in conformance with the rules of the Michigan Board of Land Surveyors or by a Decree of a Court of Law; established, re-established, monumented, re-monumented, recovered, found as expressed below:

NOTE: Not more than 4 corners, all in the same town and range, may be recorded on this certificate.

A. Description of original monument and accessories and/or subsequent restoration:

ORIGINAL B.T.'s: Hemlock, 10", S31°E, 08 lks

Original Survey by James H. Mullett in 1848. All original evidence for this corner has been destroyed.

PERPETUATION: 5/8/1975 - LCRC No. 94 recorded by G.B. Wilson, RLS No. 17607, states that he set a 2" dia. alum. pipe stamped for corner on high ground between the county road and the Menominee River, on line with the south line of Section 11, T32N-R28W, extended west 643.3 feet. - NBT's - 4" Oak - S20°W - 47.5'; 12" twin Butternut - S82°E, 36.3'.

B. Description of corner evidence found and/or method applied in restoring or reestablishing corner:

Found 2" dia. Aluminum Pipe with 3-1/4" dia. Aluminum cap as described in LCRC No. 94. This corner was established by extending the Section Line between Sections 2 and 11, T32N-R28W, west to the high bank of the Menominee River, a distance of 643.3 feet. The GLO distance is 706.2 feet. This monument was accepted as a Reference Monument to control the direction of the line between Sections 2 and 11.

C. Description of monument for corner and accessories established to perpetuate locating the position of the corner:
REFERENCE MONUMENT - Accepted existing 2" dia. Alum. Pipe / 3-1/4" dia. Alum. cap stamped for corner:

- 5/8" x 24" Iron Rod/2" Alum. cap marked WITNESS MARKER N30°W 88.21 feet
- 5/8" x 24" Iron Rod/2" Alum. cap marked WITNESS MARKER S82°E 34.90 feet
- 5/8" x 24" Iron Rod/2" Alum. cap marked WITNESS MARKER S80°W 9.69 feet
- 5/8" x 24" Iron Rod/2" Alum. cap marked WITNESS MARKER S28°E 71.64 feet
- Metal Survey Sign Post S80°W 2.1 feet


NOTE: All bearings are magnetic bearings. All distances are measured with steel tape. Distances to trees are to nail in side of tree.

5118-4
 [Signature]

RECEIVED FOR RECORD
 94 MAY 20 PM 3:30
 PAGE # 53 BK 4
 BARBARA MORRISON
 REGISTER OF DEEDS
 MENOMINEE, MI 49858

Register of Deeds Stamp & File Number

	A	B	C	D	E	F	G	H	I	J	K	L
2	6		5		4		3		2		1	
3												
4	7		8		9		10		11		12	
5												
6	18		17		16		15		14		13	
7												
8	19		20		21		22		23		24	
9												
10	30		29		28		27		26		25	
11												
12	31		32		33		34		35		36	
13												

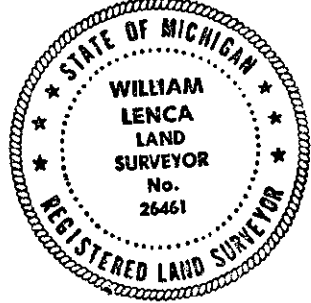

Signed by William Lenca

Date April 16, 1994

Surveyor's Michigan License No. 26461