


FOR PUBLIC LAND SURVEY CORNERS IN THE  
 T. 33N , R. 27W (MENTIONED OVER)

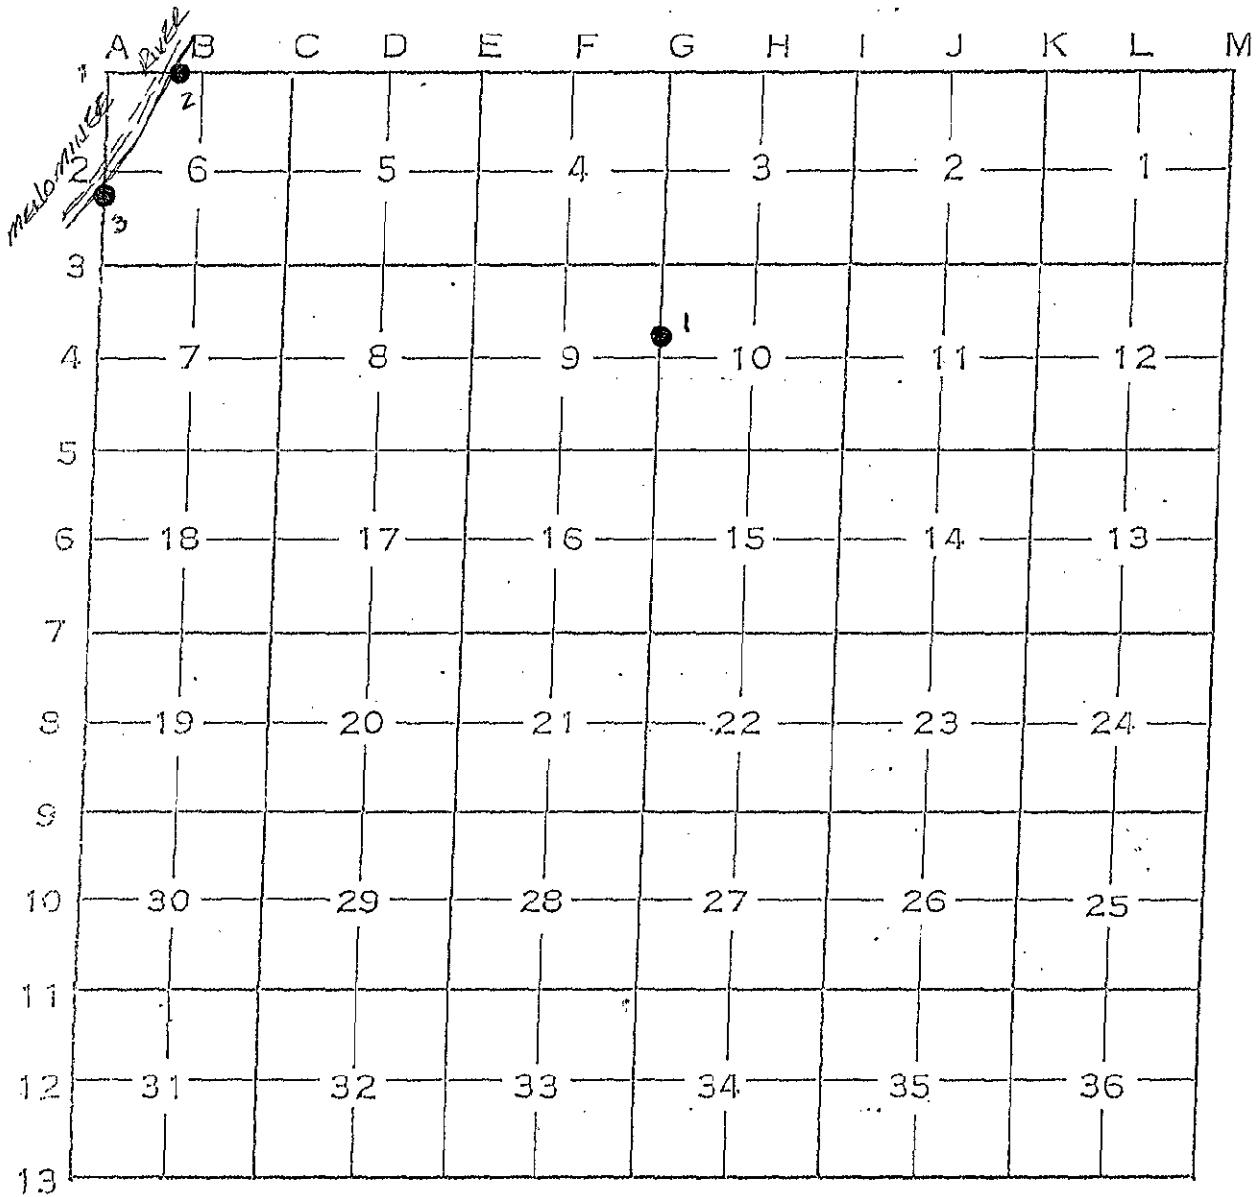

NUMBERING SYSTEM FOR MENADER/PROPERTY CONTROLLING CORNERS IN T33N - R27W  
 MENOMINEE TOWNSHIP, MENOMINEE COUNTY, MICHIGAN