

FPR 0 6 1999

SECTION

Approved by Menominee County Land Survey Remonumentation Peer Group Under Act 345 Of

P.A. Of 1990 On	12/30	199&
	SAVIS	015
P / / CL	Chairman	

LAND CORNER RECORDATION CERTIFICATE Filing Requirement of Act 74, Mich. P.A. 1970


For corners in MENOMINEE	Located In:	Corner C	ode#	
(County) 1. Public Land Survey	T <u>34N</u> R T R		C-07	
2. Property Controlling in Section 3. Miscellaneous Property in Sec.	TR TR S TR S TR S TR S TR			

Register of Deeds Stamp & File Number

4. Lot No,	Recorded Plat	
5. Private Claims		

William Lenca requirements of P.A. 74, Michigan P.A. of 1970, the corner points mentioned in lines 1 and 2 above were in conformance with regulations and rules therefore as required in the current manual of survey instructions of the United States Department of the Interior, Bureau of Land Management or by a decree of a Court of Law and /or that the corner points mentioned in lines 3, 4 and 5 above were in conformance with the rules of the Michigan Board of Land Surveyors or by a Decree of a Court of Law; established, re-established, monumented, recovered, found as expressed below:

NOTE: Not more than 2 corners, all in the same town and range, may be recorded on this certificate.

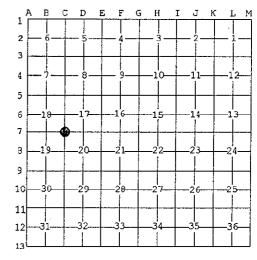


- A. Description of original monument and accessories and/or subsequent restoration:
 - Original Survey by John Mullett B.T.'s Cedar, 10" S29°E 12 lks.; Cedar, 10" S66°W 19 lks. All original evidence for this corner has been destroyed by county road improvements.
 - Certified Survey No. 184 by George B. Wilson, RLS No. 17607, shows this corner as it relates to other corners in Section 1980; 20, T34N-R25W. The corner monument is not described, and no B.T.'s are given.
 - L.C.R.C. No. 545 by William Lenca, RLS No. 26461, states: "Found corner in location indicated by existing county roads 1982: north - south and east - west. Found 3/4" Iron Pipe 16" below East edge of blacktop surface County Road." TIES: Tclephone Pole - N30°E - 22.23'; Telephone Pole - S28°E - 121.36'; Telephone Pole - S72°W - 67.42'; Telephone Pole -N270W - 86.43'.
- B. Description of corner evidence found and/or method applied in restoring or reestablishing corner:

We recovered a 3/4 inch diameter Iron Pipe in a location as described in Land Corner Recordation Certificate Number 545. The corner falls in line with an old lane to the East and the centerline of a county road to the West, and on the East edge of the asphalt surface of a North - South County Road. The distance from this corner East to the 1/4 Corner between Sections 17 and 20 fits with the distance shown in Certified Survey No. 184 as 2616.90 feet. This distance is also shown on the old Highway Plans for M-35 as 2616.80 feet. The distance South to the 1/4 Corner between Sections 17 and 18 also matches with that shown in Certified Survey No. 184. This corner monument has been accepted and used by local surveyors for many years, and is accepted as the destravation of evidence of the position of the original corner. William

C. Description of monument for corner and accessories established to perpetuate locating the position of the corner:

Set 2" dia. Aluminum Pipe 30" long/3-1/4" dia. Alum. cap stamped for corner location:

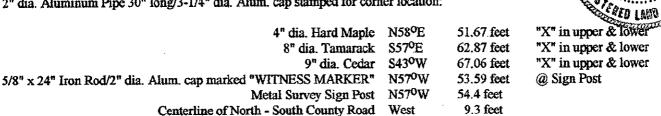

NOTE: All bearings are magnetic bearings. All distances are measured with steel tape. Distances to trees are to nail in side of tree.

Signed by 10 Mism Taxes	Date Dec. 22, 1998
Surveyor's Michigan License No. 26461	

LENCA LARD SURVEYOR

95A51