

LAND CORNER RECORDATION CERTIFICATE
Filing Requirement of Act 74, Mich. P.A. 1970 as Amended

For corners in

Menominee (County)	Located In:	Corner Code #
1. Public Land Survey	T 34N R 29W	MC W of I03
	T R	
	T R	
2. Property Controlling in Section	S T R	
	S T R	
	S T R	
3. Miscellaneous Property in Sec.	S T R	
	S T R	
4. Lot No. _____, Recorded Plat		
5. Private Claims		

Register of Deeds Stamp & File Number

	A	B	C	D	E	F	G	H	I	J	K	L	M
1													
2		6		5		4		3		2		1	
3													
4		7		8		9		10		11		12	
5													
6		18		17		16		15		14		13	
7													
8		19		20		21		22		23		24	
9													
10		30		29		28		27		26		25	
11													
12		31		32		33		34		35		36	
13													

I, Jeremy J. Pipp, in a field survey on 3/21/2012AD do hereby state
that under requirements of P.A. 74, Michigan P.A. of 1970, the corner points mentioned in lines 1 and 2
above were in conformance with regulations and rules therefore as required in the current manual of survey
instructions of the United States Department of the Interior, Bureau of Land Management or by a decree of
a Court of Law and /or that the corner points mentioned in lines 3, 4 and 5 above were in conformance with
the rules of the Michigan Board of Land Surveyors or by a Decree of a Court of Law; established,
re-established, monumented, recovered, found as expressed below:

NOTE: Not more than 2 corners, all in the same town and range, may be recorded
on this certificate.

A. Description of original monument and accessories and/or subsequent restoration:

(MC W of I03) Meander Corner common to Sections 3 and 10 on left bank of Escanaba River.
1852: Francis Coleman, DS. Set meander post witnessed by: Hickory 10 N03E 29 links
(19.14'); Elm 10 S76E 12 links (7.92').

B. Description of corner evidence found and/or method applied in restoring or reestablishing corner:


(MC W of I03) No evidence of original survey or subsequent restoration found. Corner
position reestablished on line from the Northeast corner of Section 10 to the Easterly
most point on the South line of Section 3 as depicted on the Plat of Menominee Forest
Estates #1. GLO distance from the Section corner to this position is 8.96 Chains (591.36
feet); this position falls in the water. Monumented witness position 468.40 feet West of
Section Corner and +/-25 Feet from the Waters Edge. Position is accepted as a careful and
faithful WITNESS TO the position of the original corner.

C. Description of monument for corner and accessories established to perpetuate locating the position of the corner:

(MC W of I03) DNR monument
24" Red Maple N65E 55.58' (MC,NBT)
22" Red Maple S58E 75.65' (MC,NBT)
15" Ash S20W 26.95' (MC,NBT)
16" Elm N59W 17.25' (MC,NBT)

All trees are blazed, scribed, painted,
and signed. Measurements are to nail in
side of tree, bearings are magnetic. A
metal rail & sign were set East 1.5 feet.

Signed by Jeremy J. Pipp
Surveyor's Michigan License No. 50447

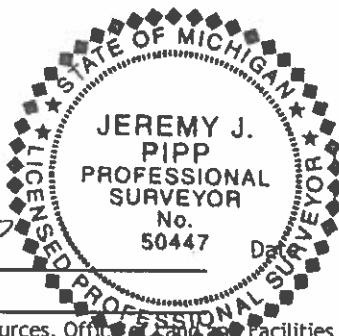

July 16, 2012

For the Michigan Department of Natural Resources, Office of Professional Facilities