

LAND CORNER RECORDATION CERTIFICATE
Filing Requirement of Act 74, Mich. P.A. 1970 as Amended

For corners in

Menominee (County)	Located In:	Corner Code #
1. Public Land Survey	T 34N R 29W	I03
	T R	
	T R	
2. Property Controlling in Section	S T R	
	S T R	
	S T R	
3. Miscellaneous Property in Sec.	S T R	
	S T R	
4. Lot No. , Recorded Plat		
5. Private Claims		

Register of Deeds Stamp & File Number

	A	B	C	D	E	F	G	H	I	J	K	L	M
1													
2	6		5		4		3		2		1		
3													
4	7		8		9		10		11		12		
5													
6	18		17		16		15		14		13		
7													
8	19		20		21		22		23		24		
9													
10	30		29		28		27		26		25		
11													
12	31		32		33		34		35		36		
13													

I, Jeremy J. Pipp, in a field survey on 3/26/2012AD do hereby state
that under requirements of P.A. 74, Michigan P.A. of 1970, the corner points mentioned in lines 1 and 2
above were in conformance with regulations and rules therefore as required in the current manual of survey
instructions of the United States Department of the Interior, Bureau of Land Management or by a decree of
a Court of Law and /or that the corner points mentioned in lines 3, 4 and 5 above were in conformance with
the rules of the Michigan Board of Land Surveyors or by a Decree of a Court of Law; established,
re-established, monumented, recovered, found as expressed below:

NOTE: Not more than 2 corners, all in the same town and range, may be recorded
on this certificate.

A. Description of original monument and accessories and/or subsequent restoration:

(I03) Corner common to Sections 2, 3, 10 and 11. 1852: Francis Coleman, DS. Set wood
post witnessed by: Black Ash 12 N55E 32 links (21.12'); Elm 10 S71W 46 links (30.36');
1994: Michigan DNR (Paul Bressette PS#37270) set DNR monument witnessed by: 10" Maple N59E
12.0', 9" Maple S65E 35.8', 13" Maple S22W 17.95', 8" Maple N42W 7.65'.

B. Description of corner evidence found and/or method applied in restoring or reestablishing corner:


(I03) Accepted found MDNR Monument and Four existing Witnesses as a careful and faithful
REESTABLISHMENT of the position of the original corner.

C. Description of monument for corner and accessories established to perpetuate locating the position of the corner:

(I03) DNR monument
EX. 16" Maple N59E 12.43' (S2,NBT)
EX. 11" Maple S65E 36.28' (S11,NBT)
EX. 19" Maple S23W 18.28' (S10,NBT)
EX. 9" Maple N42W 7.70' (S3,NBT)

All trees are blazed, scribed, painted,
and signed. Measurements are to nail in
side of tree, bearings are magnetic. A
metal rail & sign were set North 1.5
feet.

Signed by Jeremy J. Pipp
Surveyor's Michigan License No. 50447

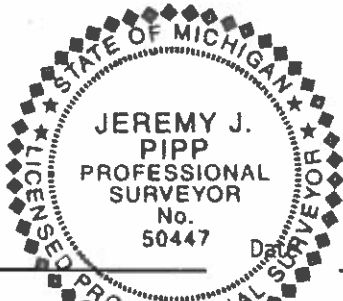

Date July 16, 2012

For the Michigan Department of Natural Resources, Office of Land and Facilities