

LAND CORNER RECORDATION CERTIFICATE
Filing Requirement of Act 74, Mich. P.A. 1970 as Amended

For corners in

Menominee (County)	Located In:	Corner Code #
1. Public Land Survey	T _____ R _____ T _____ R _____ T _____ R _____	_____
2. Property Controlling in Section	S 19 T 35N R 25W S 19 T 35N R 25W S _____ T _____ R _____	9 12 _____
3. Miscellaneous Property in Sec.	S _____ T _____ R _____ S _____ T _____ R _____	_____
4. Lot No. _____, Recorded Plat		
5. Private Claims		

Register of Deeds Stamp & File Number

	A	B	C	D	E	F	G	H	I	J	K	L	M
1													
2		6		5		4		3		2		1	
3													
4		7		8		9		10		11		12	
5													
6		18		17		16		15		14		13	
7													
8		19		20		21		22		23		24	
9													
10		30		29		28		27		26		25	
11													
12		31		32		33		34		35		36	
13													

I, Jeremy J. Pipp, in a field survey on 1/04/2012AD do hereby state
that under requirements of P.A. 74, Michigan P.A. of 1970, the corner points mentioned in lines 1 and 2
above were in conformance with regulations and rules therefore as required in the current manual of survey
instructions of the United States Department of the Interior, Bureau of Land Management or by a decree of
a Court of Law and /or that the corner points mentioned in lines 3, 4 and 5 above were in conformance with
the rules of the Michigan Board of Land Surveyors or by a Decree of a Court of Law; established,
re-established, monumented, recovered, found as expressed below:

NOTE: Not more than 2 corners, all in the same town and range, may be recorded
on this certificate.

A. Description of original monument and accessories and/or subsequent restoration:

(09) Center-East One-Sixteenth corner of Section 19. Not set in original survey, no
evidence of subsequent establishment.

(12) Center-South One-Sixteenth corner of Section 19. Not set in original survey, no
evidence of subsequent establishment.

B. Description of corner evidence found and/or method applied in restoring or reestablishing corner:

(09) Corner position established mid-point and on-line between the Center One-Quarter
corner and the East One-Quarter corner of Section 19.

(12) Corner position established mid-point and on-line between the Center One-Quarter
corner and the South One-Quarter corner of Section 19.

C. Description of monument for corner and accessories established to perpetuate locating the position of the corner:


(09)	DNR monument	(12)	DNR monument
5" B. Spruce	N42E 17.59' (1/16S,BT)	6" Ash	N47E 10.49' (1/16S,BT)
4" B. Spruce	S51E 3.96' (1/16S,BT)	7" Ash	S73E 22.61' (1/16S,BT)
5" B. Spruce	S46W 12.57' (1/16S,BT)	5" Ash	S24W 18.22' (1/16S,BT)
9" Tamarack	N19W 28.49' (1/16S,BT)	8" Ash	N60W 3.90' (1/16S,BT)
All trees are blazed, scribed, and painted. Measurements are to nail in side of tree, bearings are magnetic.		All trees are blazed, scribed, and painted. Measurements are to nail in side of tree, bearings are magnetic.	

Signed by Jeremy J. Pipp Date July 16, 2012
Surveyor's Michigan License No. 50447

For the Michigan Department of Natural Resources, Office of Land and Water Activities

20005

20004

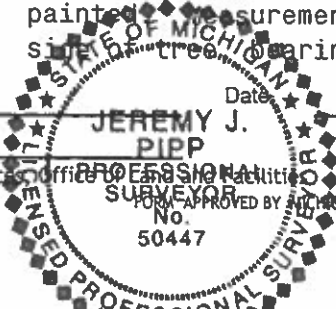

FORM APPROVED BY MICHIGAN STATE BOARD OF PROFESSIONAL SURVEYORS, JAN. 28, 1971
Revised May 14, 1975
Revised Jan., 1983
Revised Oct., 1995