

LAND CORNER RECORDATION CERTIFICATE
Filing Requirement of Act 74, Mich. P.A. 1970

For corners in

Menominee (County)	Located In:	Corner Code //
1. Public Land Survey	T 36N R 26W	I-5
	T 36N R 26W	I-6
	T 36N R 26W	I-7
	T R	
2. Property Controlling in Section	S T R	
	S T R	
3. Miscellaneous Property in Sec.	S T R	

Register of Deeds Stamp & File Number

4. Lot No. _____, Recorded Plat _____
5. Private Claims _____

I, Paul Bressette, in a field survey on June 16, 1993, do hereby certify that under requirements of P.A. 74, Michigan P.A. of 1970, the corner points mentioned in lines 1 and 2 above were in conformance with regulations and rules therefore as required in the current manual of survey instructions of the United States Department of the Interior, Bureau of Land Management or by a decree of a Court of Law and/or that the corner points mentioned in lines 3, 4 and 5 above were in conformance with the rules of the Michigan Board of Land Surveyors or by a Decree of a Court of Law; established, re-established, monumented, re-monumented, recovered, found as expressed below:

NOTE: Not more than 4 corners, all in the same town and range, may be recorded on this certificate.

A. Description of original monument and accessories and/or subsequent restoration:

I-5 Section Corner common to Sections 10, 11, 14 and 15. 1852: Francis Coleman, D.S. Set wood post witnessed by: Tamarack 6 N22°E 28 links; Tamarack 8 S08°W 13 links.

I-6 Quarter Corner common to Sections 14 and 15. Francis Coleman, D.S., 1852. Set wood post witnessed by Cedar 12 N53°E 31 links; Cedar 20 S05°W 4 links.

I-7 Section Corner common to Sections 14, 15, 22 and 23. 1852: Francis Coleman, D.S., set wood post witnessed by: Tamarack 7 N56°E 27 links; Tamarack 6 S75°W 34 links.

B. Description of corner evidence found and/or method applied in restoring or reestablishing corner:

I-5 Found stump of the NE'ly tamarack original bearing tree with lower face, measuring notch and scribing clearly visible. Rotted wood found in position of SW'ly BT. Excavation of record bearing and distance revealed a stake point. Set DNR Monument at position of stake point and witnessed.

I-6 Found stump of the NE'ly cedar original bearing tree with lower face, measuring notch, and some scribing clearly visible. Rotted wood and roots in position of SW'ly BT. No evidence of post point found. Restored corner at record bearing and distance from NE'ly OBT.

I-7 Found snag of the NE'ly tamarack original bearing tree with upper face with scribing and lower face with measuring notch but no scribing visible. No positive evidence of SW'ly BT or the post point was found. Corner position re-established at record bearing and distance from found OBT.


C. Description of monument for corner and accessories established to perpetuate locating the position of the corner:

I-5 DNR Monument

I-6 DNR Monument

I-7 DNR Monument

10" W. Pine	N62°E	27.1'	6" W. Ash	N23°E	23.0'	9" Cedar	N64°E	13.75'
6" Tamarack	S86°E	18.45'	7" Cedar	S24°E	21.95'	6" Cedar	S36°E	22.05'
8" W. Pine	S62°W	23.3'	7" Cedar	S60°W	10.7'	5" Cedar	S35°W	20.9'
6" Cedar	N25°W	20.0'	9" Y. Birch	N45°W	23.85'	5" Cedar	N41°W	7.85'

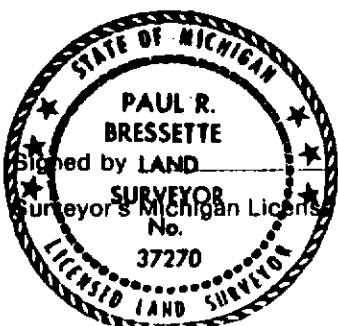

Paul R. Bressette Date 9-28-93

37270