

LAND CORNER RECORDATION CERTIFICATE
Filing Requirement of Act 74, Mich. P.A. 1970 as Amended

For corners in

Menominee (County)	Located In:	Corner Code #
1. Public Land Survey	T _____ R _____ T _____ R _____ T _____ R _____	_____
2. Property Controlling in Section	S 6 T 36N R 27W S 6 T 36N R 27W S _____ T _____ R _____	5 9 _____
3. Miscellaneous Property in Sec.	S _____ T _____ R _____ S _____ T _____ R _____	_____
4. Lot No. _____, Recorded Plat _____		
5. Private Claims _____		

Register of Deeds Stamp & File Number

1	A	B	C	D	E	F	G	H	I	J	K	L	M
2	6	5	4	3	2	1							
3													
4	7	8	9	10	11	12							
5													
6	18	17	16	15	14	13							
7													
8	19	20	21	22	23	24							
9													
10	30	29	28	27	26	25							
11													
12	31	32	33	34	35	36							
13													

I, Jeremy J. Pipp, in a field survey on 2/13/2012AD do hereby state
that under requirements of P.A. 74, Michigan P.A. of 1970, the corner points mentioned in lines 1 and 2
above were in conformance with regulations and rules therefore as required in the current manual of survey
instructions of the United States Department of the Interior, Bureau of Land Management or by a decree of
a Court of Law and /or that the corner points mentioned in lines 3, 4 and 5 above were in conformance with
the rules of the Michigan Board of Land Surveyors or by a Decree of a Court of Law; established,
re-established, monumented, recovered, found as expressed below:

NOTE: Not more than 2 corners, all in the same town and range, may be recorded
on this certificate.

A. Description of original monument and accessories and/or subsequent restoration:

(05) Center-North One-Sixteenth corner of Section 6. Not set in original survey, no
evidence of subsequent establishment.

(09) Center-East One-Sixteenth corner of Section 6. Not set in original survey, no
evidence of subsequent establishment.

B. Description of corner evidence found and/or method applied in restoring or reestablishing corner:

(05) Corner position established by single proportionate measurement between the Center
One-Quarter corner and the North One-Quarter corner of Section 6. Position falls on West
edge of County Road (Pokovich lane), and tree line East of position

(09) Corner position established mid-point and on-line between the Center One-Quarter
corner and the East One-Quarter corner of Section 6.

C. Description of monument for corner and accessories established to perpetuate locating the position of the corner:

(05)	DNR monument	(09)	DNR monument
7" Ash	S85E 51.69' (1/16S,BT)	5" Spruce	N44E 17.69' (1/16S,BT)
7" Ash	S30W 9.60' (1/16S,BT)	4" Ironwood	S71E 14.99' (1/16S,BT)
4" Ash	S70W 10.70' (1/16S,BT)	4" Elm	S38W 24.45' (1/16S,BT)
7" Ironwood	N40W 35.24' (1/16S,BT)	9" Spruce	N34W 6.11' (1/16S,BT)

All trees are blazed, scribed, and
painted. Measurements are to nail in
side of tree, bearings are magnetic.


Signed by Jeremy J. Pipp Date July 16, 2012

Surveyor's Michigan License No. 50447

For the Michigan Department of Natural Resources, in Office of _____ and Facilities

20024

20023

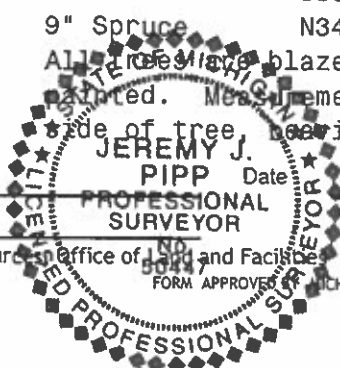

MICHIGAN STATE BOARD OF PROFESSIONAL SURVEYORS, JAN. 28, 1971

Revised May 14, 1975

Revised Jan., 1983

Revised Oct., 1995