

LAND CORNER RECORDATION CERTIFICATE
Filing Requirement of Act 74, Mich. P.A. 1970 as Amended

For corners in

Menominee (County)	Located In:	Corner Code #
1. Public Land Survey	T _____ R _____	_____
	T _____ R _____	_____
	T _____ R _____	_____
2. Property Controlling in Section	S 32 T 36N R 28W	12
	S 32 T 36N R 28W	13
	S _____ T _____ R _____	_____
3. Miscellaneous Property in Sec.	S _____ T _____ R _____	_____
	S _____ T _____ R _____	_____
4. Lot No. _____, Recorded Plat _____		
5. Private Claims		

Register of Deeds Stamp & File Number

	A	B	C	D	E	F	G	H	I	J	K	L	M
1													
2	6		5		4		3		2		1		
3													
4	7		8		9		10		11		12		
5													
6	18		17		16		15		14		13		
7													
8	19		20		21		22		23		24		
9													
10	30		29		28		27		26		25		
11													
12	31		32		33		34		35		36		
13													

I, Jeremy J. Pipp, in a field survey on 3/25/2013AD do hereby state
that under requirements of P.A. 74, Michigan P.A. of 1970, the corner points mentioned in lines 1 and 2
above were in conformance with regulations and rules therefore as required in the current manual of survey
instructions of the United States Department of the Interior, Bureau of Land Management or by a decree of
a Court of Law and /or that the corner points mentioned in lines 3, 4 and 5 above were in conformance with
the rules of the Michigan Board of Land Surveyors or by a Decree of a Court of Law; established, re-established,
monumented, recovered, found as expressed below:

NOTE: Not more than 2 corners, all in the same town and range, may be recorded
on this certificate.

A. Description of original monument and accessories and/or subsequent restoration:

(12) Center-South One-Sixteenth corner of Section 32. Not set in original survey.
1986: William Lenca (PS#26461) noted set monument.

(13) Southeast One-Sixteenth corner of Section 32. Not set in original survey, no
evidence of subsequent establishment.

B. Description of corner evidence found and/or method applied in restoring or reestablishing corner:

(12) Corner position established mid-point and on-line between the Center One-Quarter
corner and the South One-Quarter corner of Section 32. Accepted found Menominee County
Remon Monument and adjacent carsonite post as marking the corner position.

(13) Corner position established at the intersection of the South and East One-
Sixteenth lines of Section 32.

C. Description of monument for corner and accessories established to perpetuate locating the position of the corner:

(12) DNR monument
8" Cherry N38E 47.90' (1/16S,NBT)
12" Spruce S12E 18.48' (1/16S,NBT)
6" Maple N70W 70.62' (1/16S,NBT)
11" Cedar N11W 57.65' (1/16S,NBT)


All trees are blazed, scribed, and
painted. Measurements are to nail in
side of tree, bearings are magnetic.

(13) DNR monument
6" Maple N24E 21.74' (1/16S,BT)
15" Oak S58E 58.04' (1/16S,BT)
9" Maple N76W 57.23' (1/16S,BT)
8" Maple N48W 16.32' (1/16S,BT)

All trees are blazed, scribed, and
painted. Measurements are to nail in
side of tree, bearings are magnetic.

Signed by Jeremy J. Pipp
Surveyor's Michigan License No. 50447

For the Michigan Department of Natural Resources Forest Resource Division

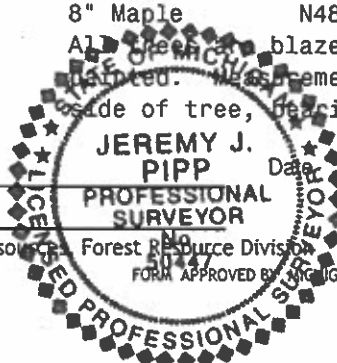

Date July 30, 2013