

LAND CORNER RECORDATION CERTIFICATE  
Filing Requirement of Act 74, Mich. P.A. 1970 as Amended

For corners in

Menominee (County)	Located In:	Corner Code #
1. Public Land Survey	T _____ R _____ T _____ R _____ T _____ R _____	_____
2. Property Controlling in Section	S 17 T 37N R 27W S _____ T _____ R _____ S _____ T _____ R _____	11
3. Miscellaneous Property in Sec.	S _____ T _____ R _____ S _____ T _____ R _____	_____
4. Lot No. _____, Recorded Plat		
5. Private Claims		

Register of Deeds Stamp & File Number

	A	B	C	D	E	F	G	H	I	J	K	L	M
1													
2	6		5		4		3		2		1		
3													
4	7		8		9		10		11		12		
5													
6	18		17		16		15		14		13		
7													
8	19		20		21		22		23		24		
9													
10	30		29		28		27		26		25		
11													
12	31		32		33		34		35		36		
13													

I, Jeremy J. Pipp, in a field survey on 12/19/2012AD do hereby state  
that under requirements of P.A. 74, Michigan P.A. of 1970, the corner points mentioned in lines 1 and 2  
above were in conformance with regulations and rules therefore as required in the current manual of survey  
instructions of the United States Department of the Interior, Bureau of Land Management or by a decree of  
a Court of Law and /or that the corner points mentioned in lines 3, 4 and 5 above were in conformance with  
the rules of the Michigan Board of Land Surveyors or by a Decree of a Court of Law; established,  
re-established, monumented, recovered, found as expressed below:

NOTE: Not more than 2 corners, all in the same town and range, may be recorded  
on this certificate.

A. Description of original monument and accessories and/or subsequent restoration:

(11) Southwest One-Sixteenth corner of Section 17. Not set in original survey, no  
evidence of subsequent establishment.

B. Description of corner evidence found and/or method applied in restoring or reestablishing corner:


(11) Corner position established at the intersection of the South and West One-Sixteenth  
lines of Section 17.

C. Description of monument for corner and accessories established to perpetuate locating the position of the corner:

(11) DNR monument  
5" Maple N56E 17.83' (1/16S,BT)  
5" Maple S30E 27.16' (1/16S,BT)  
6" Maple S67W 41.28' (1/16S,BT)  
5" Maple N39W 20.07' (1/16S,BT)

All trees are blazed, scribed, and  
painted. Measurements are to nail in  
side of tree, bearings are magnetic.

Signed by Jeremy J. Pipp  
Surveyor's Michigan License No. 50447

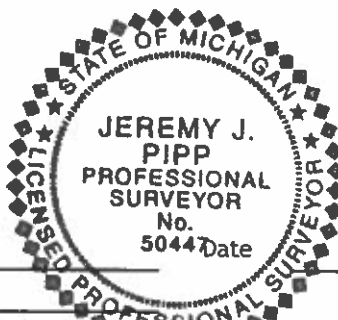

July 18, 2013

For the Michigan Department of Natural Resources, Forest Resources Division