

LAND CORNER RECORDATION CERTIFICATE
Filing Requirement of Act 74, Mich. P.A. 1970 as Amended

For corners in

<u>Menominee</u> (County)	Located In:	Corner Code #
1. Public Land Survey	T 40N R 25W	D10
	T _____ R _____	_____
	T _____ R _____	_____
2. Property Controlling Section	S _____ T _____ R _____	_____
	S 29 T 40N R 25W	09
	S _____ T _____ R _____	_____
3. Miscellaneous Property in Sec.	S _____ T _____ R _____	_____
	S _____ T _____ R _____	_____

4. Lot No. _____, Recorded Plat _____
 5. Private Claims _____

Register of Deeds Stamp & File Number

	A	B	C	D	E	F	G	H	I	J	K	L	M
1													
2	6			5			4		3			2	1
3													
4	7			8			9		10			11	12
5													
6	16			17			16		15			14	13
7													
8	19			20			21		22			23	24
9													
10	30			31			28		27			26	25
11													
12	31			32			33		34			35	36
13													

Jeremy J. Pipp, in a field survey on 3/05/2014 do hereby state

that under requirements of P.A. 74, Michigan P.A. of 1970, the corner points mentioned in lines 1 and 2 above were in conformance with regulations and rules therefore as required in the current manual of survey instructions of the United States Department of the Interior, Bureau of Land Management or by a decree of a Court of Law and /or that the corner points mentioned in lines 3, 4 and 5 above were in conformance with the rules of the Michigan Board of Land Surveyors or by a Decree of a Court of Law; established, re-established, monumented, recovered, found as expressed below:

NOTE: Not more than 2 corners, all in the same town and range, may be recorded on this certificate.

A. Description of original monument and accessories and/or subsequent restoration:

(D10) Center One-Quarter Corner of Section 29. Not set in original survey, no evidence of subsequent establishment.

(09) Center-East One-Sixteenth corner of Section 29. Not set in original survey. Found 1" pipe N25-23-33W, 33.32 feet from calculated position. Existing Blue lines East and North better match Calculated position.

B. Description of corner evidence found and/or method applied in restoring or reestablishing corner:

(D10) Corner position established at the intersection of the North-South and East-West One-Quarter lines of Section 29.

(09) Corner position established mid-point and on-line between the Center One-Quarter corner and the East One-Quarter corner of Section 29. Above noted found pipe not accepted.

C. Description of monument for corner and accessories established to perpetuate locating the position of the corner:


(D10) DNR monument	(09) DNR monument
5" Cedar N57E 15.55' (1/4S,BT)	11" Hemlock N65E 31.98' (1/16S,BT)
13" Hemlock S12E 7.88' (1/4S,BT)	7" Maple S70E 33.42' (1/16S,BT)
10" Hemlock S45W 15.23' (1/4S,BT)	7" Maple S02E 5.05' (1/16S,BT)
7" Cedar N08W 14.07' (1/4S,BT)	6" Maple N20W 26.81' (1/16S,BT)

All trees are blazed, scribed, and painted. Measurements are to nail in side of tree, bearings are magnetic.

All trees are blazed, scribed, and painted. Measurements are to nail in side of tree, bearings are magnetic.

Signed by Jeremy J. Pipp
 Surveyor's Michigan License No. 50447

Date July 9, 2014

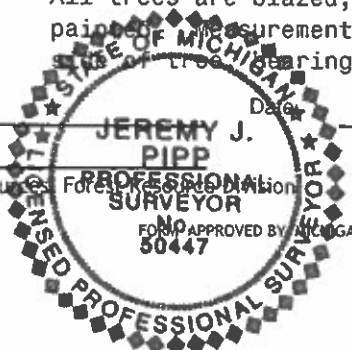

For the Michigan Department of Natural Resources and Forestry APPROVED BY THE MICHIGAN STATE BOARD OF PROFESSIONAL SURVEYORS, JAN. 28, 1971