

LAND CORNER RECORDATION CERTIFICATE
Filing Requirement of Act 74, Mich. P.A. 1970 as Amended

For corners in

Menominee Located In: Corner Code #
1. Public Land Survey
2. Property Controlling Section
3. Miscellaneous Property in Sec.

4. Lot No. , Recorded Plat
5. Private Claims

6/03/2014
Jeremy J. Pipp, in a field survey on 6/03/2014 do hereby state
that under requirements of P.A. 74, Michigan P.A. of 1970, the corner points mentioned in lines 1 and 2 above were in conformance with regulations and rules therefore as required in the current manual of survey instructions of the United States Department of the Interior, Bureau of Land Management or by a decree of Court of Law and /or that the corner points mentioned in lines 3, 4 and 5 above were in conformance with the rules of the Michigan Board of Land Surveyors or by a Decree of a Court of Law; established, re-established, monumented, recovered, found as expressed below:

NOTE: Not more than 2 corners, all in the same town and range, may be recorded on this certificate.

A. Description of original monument and accessories and/or subsequent restoration:

(E10) Quarter corner common to Sections 28 and 29. 1852: Harvey Mellen, DS. Set quarter section corner post witnessed by Tamarack 14 N51E 29 links (19.14'), Cedar 6 S10W 8 links (5.28'). 1964: Kimberly Clark Corp. (Neal Sperhake PS#7876) Set 1" pipe with 4" Aluminum cap on site of original post as determined from existing original bearing tree (Tamarack 14 N51E 50 lks) witnessed by 8" Cedar N61W 23 links (15.18'), 10" Cedar S30E 6 links (3.96').

(E11) Section corner common to Sections 28, 29, 32, and 33. 1852: Harvey Mellen, DS. Set section corner post witnessed by Cedar 12 S04W 15 links (9.90'), W. Birch 7 N35E 22 links (14.52'). 1971: Michigan DNR (Frank Bray PS#13575) Set 1" pipe with 4" Aluminum cap in place of found wood post (with supporting blazed trees and signature tree) witnessed by 7" Hemlock S75E 4.8', 9" Hemlock S20W 11.9'.

B. Description of corner evidence found and/or method applied in restoring or reestablishing corner:

(E10) Accepted found Kimberly Clark monument, mound in position of record OBT NE, and Two NBT witnesses (both living). Position is accepted as a careful and faithful PERPETUATION of the position of the original corner.

(E11) Accepted found MDNR Monument and One NBT Witness (SW NBT living, mound remains of SE NBT). Position is accepted as a careful and faithful REESTABLISHMENT of the position of the original corner. Existing Monument is bent with a Broken Cap, replaced with straight 1" pipe and new cap.

C. Description of monument for corner and accessories established to perpetuate locating the position of the corner:

(E10) DNR monument
9" Cedar N61E 3.80' (1/4S,NBT)
EX 11" Cedar S26E 4.06' (1/4S,NBT)
5" Cedar S23W 4.53' (1/4S,NBT)
EX 10" Cedar N60W 14.49' (1/4S,NBT)
All trees are blazed, scribed, painted, and signed. Measurements are to nail in side of tree, bearings are magnetic. A Metal sign post was set North 1.5 feet.
Signed by
Surveyor's Michigan License No. 50447

(E11) DNR monument
13" Hemlock N61E 22.60' (S 28,NBT)
13" Cedar S32E 5.62' (S 33,NBT)
EX 12" Hemlock S19W 12.50' (S 32,NBT)
9" Cedar N50W 24.34' (S 29,NBT)
All trees are blazed, scribed, painted, and signed. Measurements are to nail in side of tree, bearings are magnetic. A Metal sign post was set S82E 1.75 feet.
Signed by
Date: July 9, 2014

For the Michigan Department of Natural Resources

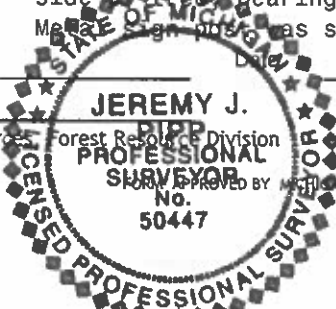


Table with 13 rows and 13 columns (A-M) for Register of Deeds Stamp & File Number. Contains numerical data for each cell.