

LAND CORNER RECORDATION CERTIFICATE
Filing Requirement of Act 74, Mich. P.A. 1970 as Amended

or corners in

Menominee (County) Located In: Corner Code #
Public Land Survey
Property Controlling Section
Miscellaneous Property in Sec.

Lot No. Recorded Plat
Private Claims

Jeremy J. Pipp, in a field survey on 7/03/2013AD do hereby state
that under requirements of P.A. 74, Michigan P.A. of 1970, the corner points mentioned in lines 1 and 2
above were in conformance with regulations and rules therefore as required in the current manual of survey
instructions of the United States Department of the Interior, Bureau of Land Management or by a decree of
Court of Law and /or that the corner points mentioned in lines 3, 4 and 5 above were in conformance with
the rules of the Michigan Board of Land Surveyors or by a Decree of a Court of Law; established,
re-established, monumented, recovered, found as expressed below:

NOTE: Not more than 2 corners, all in the same town and range, may be recorded
on this certificate.

A. Description of original monument and accessories and/or subsequent restoration:

(01) West One-Sixteenth corner common to Sections 26 and 35. Not set in original
survey, no evidence of subsequent establishment.

(05) Center-North One-Sixteenth corner of Section 35. Not set in original survey, no
evidence of subsequent establishment.

B. Description of corner evidence found and/or method applied in restoring or reestablishing corner:

(01) Corner position established mid-point and on-line between the North One-Quarter
corner and the Northwest corner of Section 35.

(01) Corner position established mid-point and on-line between the North One-Quarter
corner and the Northwest corner of Section 35.

C. Description of monument for corner and accessories established to perpetuate locating the position of the corner:

(01) DNR monument
10" Maple N35E 53.09' (1/16S,BT)
9" Maple N82E 58.14' (1/16S,BT)
3" Tamarack S40W 26.44' (1/16S,BT)
11" Maple N42W 46.80' (1/16S,BT)
All trees are blazed, scribed, and
painted. Measurements are to nail in
side of tree, bearings are magnetic.
(05) DNR monument
9" Maple N48E 30.76' (1/16S,BT)
6" Maple S17E 11.70' (1/16S,BT)
4" Tamarack S46W 45.63' (1/16S,BT)
8" ASH N10W 14.76' (1/16S,BT)
All trees are blazed, scribed, and
painted. Measurements are to nail in
side of tree, bearings are magnetic.

Signed by Jeremy J. Pipp Date August 08, 2013
Surveyor's Michigan License No. 50447

For the Michigan Department of Natural Resources Forest Resource Division

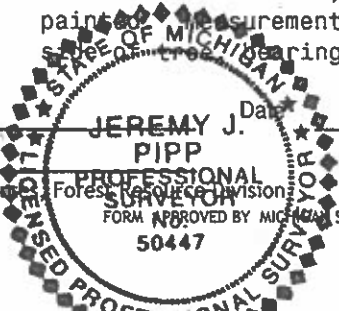


Table with 13 rows and 13 columns (A-M) for Register of Deeds Stamp & File Number. Contains numbers 1-36 and a small diagram of a corner point.