

ALSO T41N-R25W A02
ALSO T41N-R25W A04
For corners in

LAND CORNER RECORDATION CERTIFICATE
Filing Requirement of Act 74, Mich. P.A. 1970 as Amended

Menominee	Located In:	Corner Code #
(County)		
1. Public Land Survey	T 41N R 26W	M02
	T 41N R 26W	M04
	T R	
2. Property Controlling in Section	S T R	
	S T R	
	S T R	
3. Miscellaneous Property in Sec.	S T R	
	S T R	
4. Lot No. , Recorded Plat		
5. Private Claims		

I, Jeremy J. Pipp, in a field survey on 10/30/2013 do hereby state that under requirements of P.A. 74, Michigan P.A. of 1970, the corner points mentioned in lines 1 and 2 above were in conformance with regulations and rules therefore as required in the current manual of survey instructions of the United States Department of the Interior, Bureau of Land Management or by a decree of a Court of Law and /or that the corner points mentioned in lines 3, 4 and 5 above were in conformance with the rules of the Michigan Board of Land Surveyors or by a Decree of a Court of Law; established, re-established, monumented, recovered, found as expressed below:

NOTE: Not more than 2 corners, all in the same town and range, may be recorded on this certificate.

A. Description of original monument and accessories and/or subsequent restoration:

(M02) Quarter corner common to Sections 1 [T41N-R26W] and 6 [T41N-R25W]. 1846: Austin Burt, DS. Set Cedar quarter section post witnessed by Cedar 6 S82W 9 links (5.94'), Spruce 6 N53E 15 links (9.90'). No evidence of subsequent establishment.

(M04) Quarter corner common to Sections 12 [T41N-R26W] and 7 [T41N-R25W]. 1846: Austin Burt, DS. Set Cedar quarter section post witnessed by Fir 8 S28E 18 links (11.88'), Fir 12 N64W 14 links (9.24'). No evidence of subsequent establishment.

B. Description of corner evidence found and/or method applied in restoring or reestablishing corner:

(M02) No evidence of original survey. Corner position reestablished by single proportionate measurement between the Northeast corner and the Southeast corner of Section 1. Location is adjacent to an existing squared 10" Cedar. Position is accepted as a careful and faithful REESTABLISHMENT of the position of the original corner.

(M04) No evidence of original survey. Corner position reestablished by single proportionate measurement between the Northeast corner and the Southeast corner of Section 12. Position is accepted as a careful and faithful REESTABLISHMENT of the position of the original corner.

C. Description of monument for corner and accessories established to perpetuate locating the position of the corner:


(M02)	DNR monument	(M04)	DNR monument
7" Cedar	N72E 16.27' (1/4S,NBT)	18" W. Pine	N66E 73.71' (1/4S,NBT)
9" Cedar	S56E 3.07' (1/4S,NBT)	26" W. Pine	S46E 35.52' (1/4S,NBT)
11" Cedar	S20W 2.34' (1/4S,NBT)	24" W. Pine	S37W 104.38' (1/4S,NBT)
6" Cedar	N53W 3.21' (1/4S,NBT)	10" Cedar	N23W 52.78' (1/4S,NBT)
All trees are blazed, scribed, painted, and signed. Measurements are to nail in side of tree, bearings are magnetic. A Metal sign post was set North 1.5 feet.		All trees are blazed, scribed, painted, and signed. Measurements are to nail in side of tree, bearings are magnetic. A Metal sign post was set North 1.5 feet.	
Signed by <u>Jeremy J. Pipp</u>		Signed <u>August 25, 2014</u>	

Surveyor's Michigan License No. 50447

For the Michigan Department of Natural Resources, Professional Surveyor

20408

20407

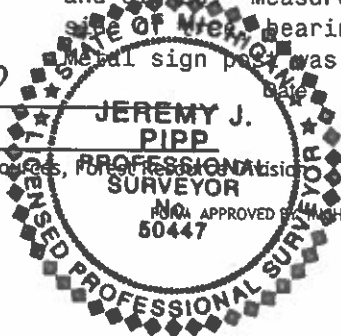

Register of Deeds Stamp & File Number

	A	B	C	D	E	F	G	H	I	J	K	L	M
1													
2	6		5		4		3		2		1		
3													
4	7		8		9		10		11		12		
5													
6	18		17		16		15		14		13		
7													
8	19		20		21		22		23		24		
9													
10	30		29		28		27		26		25		
11													
12	31		32		33		34		35		36		
13													