

LAND CORNER RECORDATION CERTIFICATE

Filing Requirement of Act 74, Mich. PA 1970

Received
MONTMORENCY COUNTY, MI
01-24-2012 09:37 am.

For Corners In: Montmorency (County)	Located in	Corner Code #	
1. Public Land Survey	T 29N R 01E	C-3	
	T	R	
2. Property Controlling in Section	S 6 T	R	
	S T	R	
3. Miscellaneous Property in Section	S T	R	
	S T	R	

201200049474
Filed for Record in
MONTMORENCY COUNTY, MI
THERESA WALKER, REGISTER OF DEEDS
01-24-2012 At 09:39:12 am.
LAND CORNER 14.00
Liber 1 Page 760 - 760

Instrument 201200049474 Liber Page 1 760


Register of Deeds Stamp & File Number

4. Lot No: _____ Recorded Plat: _____

5. Private Claims: _____

I, Carl T. Kiiskila, in a field survey on August 11, 2011 do hereby state that under requirements of PA 74, Michigan PA of 1970, the corner points mentioned in lines 1 and 2 above were in conformance with regulations and rules therefore as required in the current manual of survey instructions of the United States Department of the Interior, Bureau of Land Management or by a decree of a Court of Law and/or that the corner points mentioned in lines 3, 4 and 5 above were in conformance with the rules of the Michigan Board of Land Surveyors or by a Decree of a Court of Law, established, re-established, monumented, recovered, found as expressed below:

NOTE: Not more than 2 corners, all in the same town and range, may be recorded on this certificate.

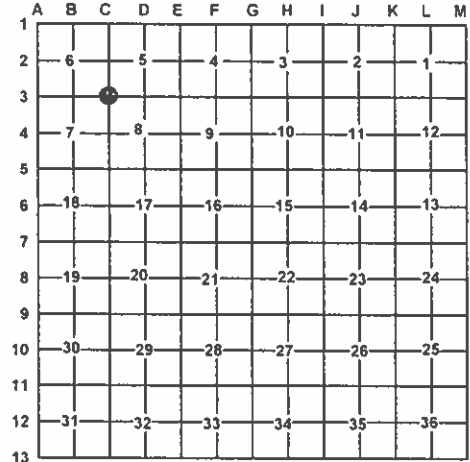

A. Description of original monument and accessories and/or subsequent restoration:

C-3 - Section corner common to sections 5,6,7 & 8, T31N,R01E

- 1840 - GLO - Lewis Clason - Set post for corner.
Y. Pine 8 S12°W 31
Sp. Pine 10 N13°E 21
- 1977 - L.C.R.C. - L.1, p.191 - Donald E. Marlatt, P.S.#18660 - Fnd. Sq. stk. & NBT's - Set iron and cap.
N17°W 24.5' 20" Oak (NBT)
S68°E 17.6' 6" Oak (NBT)
S20°E 25.25' 6" Maple
- 1998 - Remon L.C.R.C. - L.12, p.321 - Fred King, P.S.#25852 - Set concrete monument at Donald E. Marlatt's Iron and cap.
N65°E 28.04' set S&T on S side 6" Oak
S20°E 24.75' set S&T on E side 14" Maple
S40°W 57.48' set S&T on NW side 8" J. Pine
N17°W 25.62' set S&T on E side 24" Oak

B. Description of corner evidence found and/or method applies in restoring or re-establishing corner:

C-3 - Section corner common to sections 5,6,7 & 8, T31N,R01E

Found 3" dia. aluminum stamped cap on 4" dia. concrete monument per Remon L.C.R.C. - L.12, p.321. Accepted found monument as the best available evidence for the position of the original corner. Found no other evidence to dispute the location for the corner. Corner falls 15' SE of bend in 2-track trail road that runs North and West.

C. Description of monument for corner and accessories established to perpetuate locating the position of the corner:

C-3 - Section corner common to sections 5,6,7 & 8, T31N,R01E

3" dia. stamped aluminum cap on 4" dia. concrete monument.

Witnesses:

- N06°E 63.20' to set N&T on E side 24" R. Oak
- *N22°E 25.61' to fd. N&T on E side 24" R. Oak stump
- *N70°E 27.53' to fd. N&T on S side 9" R. Oak
- S11°E 25.47' to set N&T on E side 8" R. Maple
- *S40°W 57.50' to fd. N&T on W side 11" J. Pine
- Set blue carsonite post 1' North

* Witness of previous record.



Carl T. Kiiskila

1-4-12

Surveyor's Michigan License No.: 33981