

SECTION

LAND CORNER RECORDATION CERTIFICATE

Filing Requirement of Act 74, Mich. P.A. 1970

For corners in

<u>MONTMORENCY</u> (County)	Located In:	Corner Code #
<u>ALBERT TWP.</u>	T <u>29N</u> R <u>RTE</u>	<u>M.P.# 8</u>
1. Public Land Survey	T _____ R _____	_____
	T _____ R _____	_____
	T _____ R _____	_____
	T _____ R _____	_____
2. Property Controlling in Section	S _____ T _____ R _____	_____
	S _____ T _____ R _____	_____
3. Miscellaneous Property in Sec.	S _____ T _____ R _____	_____
	S _____ T _____ R _____	_____

STATE OF MICHIGAN
MONTMORENCY COUNTY
Recorded & Filed

12-16-1997 10:53:30

A. PANGAN-MCELROY
REGISTER OF DEEDS

Register of Deeds Stamp & File Number

4. Lot No. _____, Recorded Plat _____
5. Private Claims _____

I, DONALD E MARLATT, in a field survey on 11/9, 19 97

do hereby certify that under requirements of P.A. 74, Michigan P.A. of 1970, the corner points mentioned in lines 1 and 2 above were in conformance with regulations and rules therefore as required in the current manual of survey instructions of the United States Department of the Interior, Bureau of Land Management or by a decree of a Court of Law and/or that the corner points mentioned in lines 3, 4 and 5 above were in conformance with the rules of the Michigan Board of Land Surveyors or by a Decree of a Court of Law; established, re-established, monumented, re-monumented, recovered, found as expressed below:

	A	B	C	D	E	F	G	H	I	J	K	L	M
2	6	5	4	3	2	1							
3													
4	7	8	9	10	11	12							
5													
6	18	17	16	15	14	13							
7													
8	19	20	21	22	23	24							
9													
10	30	29	28	27	26	25							
11													
12	31	32	33	34	35	36							
13													

NOTE: Not more than 4 corners, all in the same town and range, may be recorded on this certificate.

A. Description of original monument and accessories and/or subsequent restoration:

M.P. # 8 M.P. COMMON TO SEC.'S 27 & 34 ON EAST SHORE OF E. TWIN LAKE.
GLO CORNER MARKED BY LEWIS CLASON APRIL 1840. Y. PINE 20"DIA. ON EAST MARGIN OF LAKE.
F. SMITH NOTES-FOUND IRON PIPE. OAK 12" S52°45'W 16.5', BIRCH 4" N33°15'E 40.5'
SETS DIRECTLY IN LINE WITH OLD FENCE CORNER. DATED 10/1/51.
SURVEY-NO DATE, NAME, OR DESCRIPTION OF CORNER.
SURVEY BY THORSEN 8/6/56. FOUND PIPE.
SURVEY BY G. HENNING 8/2/66. SET 1/2"PIPE.
SURVEY BY G. HENNING 10/31/66. USED 1/2"ROD.

B. Description of corner evidence found and/or method applied in restoring or reestablishing corner:

M.P.# 8 M.P. COMMON TO SEC.'S 27 & 34 ON EAST SHORE OF EAST TW. LAKE.
FOUND 1/2"ROD WITH 1"PIPE ALONG SIDE.
S55°W 24"OAK 16.5'
N35°E 9"BIRCH 40.5' F.SMITH WITNESSES


**APPROVED BY
PEER GROUP**

JUL 11 97

D.E.B.

C. Description of monument for corner and accessories established to perpetuate locating the position of the corner:

M.P. # 8 M.P. COMMON TO SEC.'S 27 & 34 ON EAST SHORE OF EAST TWIN LAKE.
SET CONC. MONUMENT & REMON. CAP IN PLACE OF 1/2"ROD.
S60°E 12"N.PINE 3.2'
N35°E 9"BIRCH 40.5'
S55°W 24"OAK 16.5'
S28°E 10"SPRUCE 16.47'

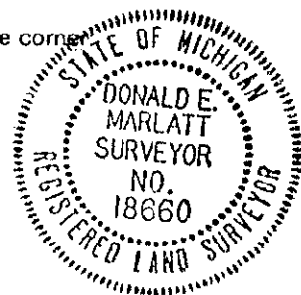

WITNESSES MARKED WITH 40 PENNY SPIKES AND P.S. TAGS # 18660.
APPROVED BY PEER GROUP JULY 11, 1997 as THE BEST AVAILABLE EVIDENCE OF THE POSITION OF THE ORIGINAL CORNER.

Signed by Donald E Marlatt

Date 12/15/1997

Surveyor's Michigan License No. 18660