

# LAND CORNER RECORDATION CERTIFICATE

Filing Requirement of Act 74, Mich. PA 1970

For Corners In: <u>Montmorency</u> (County)	Located In	Corner Code #	
1. Public Land Survey	T <u>29N</u> R <u>03E</u>	<u>A-8</u>	
	T _____ R _____	_____	
2. Property Controlling in Section	S _____ T _____ R _____	_____	
	S _____ T _____ R _____	_____	
3. Miscellaneous Property in Section	S <u>19</u> T <u>29 N</u> R <u>03E</u>	<u>13</u>	
	S _____ T _____ R _____	_____	
4. Lot No: _____	Recorded Plat: _____		
5. Private Claims: _____			

Received  
 MONTMORENCY COUNTY, MI  
 01-24-2012 09:37 am.


201200049475  
 Filed for Record in  
 MONTMORENCY COUNTY, MI  
 TERESA WALKER, REGISTER OF DEEDS  
 01-24-2012 at 09:39:24 am.  
 LAND CORNER 14.00  
 Liber 1 Page 761 - 761

Instrument Liber Page  
 201200049475 1 761

**Register of Deeds Stamp & File Number**

I, Carl T. Kiiskila, in a field survey on January, 9 2012 do hereby state that under requirements of PA 74, Michigan PA of 1970, the corner points mentioned in lines 1 and 2 above were in conformance with regulations and rules therefore as required in the current manual of survey instructions of the United States Department of the Interior, Bureau of Land Management or by a decree of a Court of Law and/or that the corner points mentioned in lines 3, 4 and 5 above were in conformance with the rules of the Michigan Board of Land Surveyors or by a Decree of a Court of Law, established, re-established, monumented, recovered, found as expressed below:

**NOTE: Not more than 2 corners, all in the same town and range, may be recorded on this certificate.**

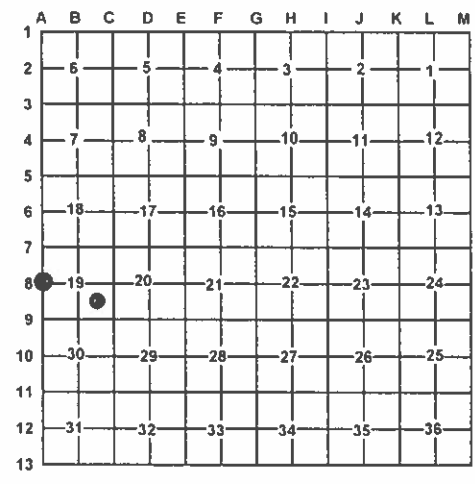

**A. Description of original monument and accessories and/or subsequent restoration:**

<p><u>A-8</u> – West ¼ corner Section 19, T29N,R03E                  Liber 12, Page 11, 1993 Montmorency County                  Remonumentation Donald Marlatt P.S.#18660                  set a Re-Mon. cap on found ½" iron.                  S17°E 5.60' 12" Oak                  N70°W 19.93' 10" Oak                  N35°E 14.89' 12" Oak                  N08°E 35.88' 16" Oak</p>	<p><u>13</u> – SE 1/16 Corner of section 19, T29N,R03E                  1971 Delmer Porter P.S.#15410 set a ½" bar W /P.S. cap per                  standard BLM procedure.</p>
--	---

**B. Description of corner evidence found and/or method applies in restoring or re-establishing corner:**

<p><u>A-8</u> – West ¼ corner Section 19, T29N,R03E                  Found a ½" rod with P.S. Cap #18660 fitting D. Marlatt's                  Witnesses</p>	<p><u>13</u> – SE 1/16 Corner of section 19, T29N,R03E                  Found a ½" x 24" bar with illegible P.S. cap fitting the standard                  BLM procedure for subdivision of a section.</p>
--	--

**C. Description of monument for corner and accessories established to perpetuate locating the position of the corner:**

<p><u>A-8</u> – Center of Section 19, T29N,R03E                  Replaced ½" rod with Standard DNR Monument</p> <p>Wit: N03°E 35.91' set N&amp;T on E side 17" R. Oak                  N29°E 14.83' Fd N&amp;T #18660 SE side 12" R. Oak                  S23°E 5.57' to set N&amp;T on W side 13" R. Oak                  S62°W 19.99' Fd N&amp;T #18660 N side 10" Twin R. Oak                  Set Blue Carsonite post 1' North</p>	<p><u>13</u> – SE 1/16 Corner of section 19, T29N,R03E                  Replaced ½" rod with Stamped 2" dia. alum. cap                  on 5/8"x 34" rebar.</p> <p>Wit: N56°E 17.00' to set N&amp;T on NW side 8" R. Maple                  S50°E 27.07' to set N&amp;T on SW side 19" R. Pine                  S41°W 18.31' to set N&amp;T on NW side 9" R. Oak                  N79°W 22.62' to set N&amp;T on NE side 13" Basswood                  Set Blue Carsonite post w/location tag 1' North.</p>
--	---

Carl T. Kiiskila

Surveyor's Michigan License No.: 33981



1-23-12