

# LAND CORNER RECORDATION CERTIFICATE

Filing Requirement of Act 74, Mich. PA 1970



For Corners In: Montmorency (County)	Located In	Corner Code #
1. Public Land Survey	T _____ R _____	_____
	T _____ R _____	_____
2. Property Controlling in Section	S 28 T 30N R 2E	2
	S 28 T 30N R 2E	13
3. Miscellaneous Property in Section	S _____ T _____ R _____	_____
	S _____ T _____ R _____	_____

4. Lot No: \_\_\_\_\_ Recorded Plat: \_\_\_\_\_

5. Private Claims: \_\_\_\_\_

I, Carl T. Kiiskila, in a field survey on April 18, 2001 do hereby state that under requirements of PA 74, Michigan PA of 1970, the corner points mentioned in lines 1 and 2 above were in conformance with regulations and rules therefore as required in the current manual of survey instructions of the United States Department of the Interior, Bureau of Land Management or by a decree of a Court of Law and/or that the corner points mentioned in lines 3, 4 and 5 above were in conformance with the rules of the Michigan Board of Land Surveyors or by a Decree of a Court of Law; established, re-established, monumented, recovered, found as expressed below:

**NOTE: Not more than 2 corners, all in the same town and range, may be recorded on this certificate.**

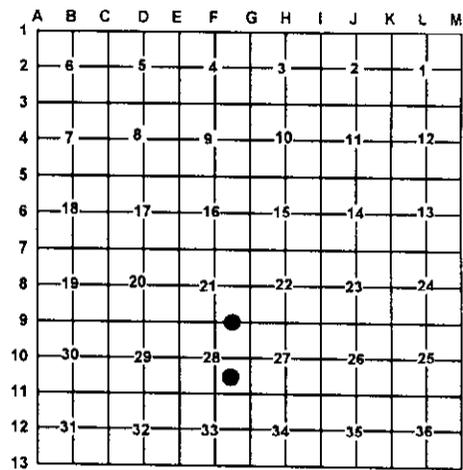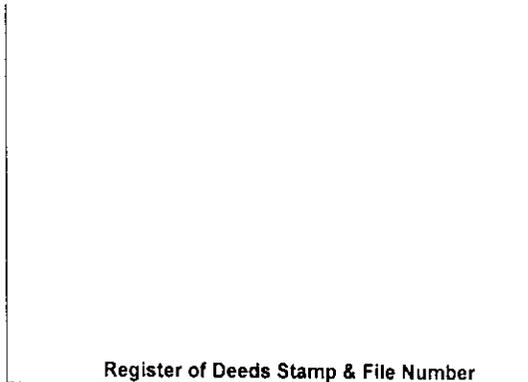

A. Description of original monument and accessories and/or subsequent restoration:

2-This corner position was not established during the original government survey.      13-This corner position was not established during the original government survey.

B. Description of corner evidence found and/or method applies in restoring or re-establishing corner:

2- Established the Northeast corner of the Northwest quarter of the Northeast quarter of section 28 per B.L.M. instructions for the subdivision of a section.      13- Established the Northwest corner of the Northeast quarter of the Southeast quarter of section per 28 B.L.M. instructions for the subdivision of a section.

C. Description of monument for corner and accessories established to perpetuate locating the position of the corner:

2- Set 5/8" X 32" rerod with P.S. cap #33981 Wit: 5" Red Pine      N24°W      39.04' 6" Spruce         S03°E      51.83' 6"-8" Triple Apple    N35°W      24.71' 14" Cedar            S38°W      64.34' Corner is in centerline of E-W gravel road	13- Set 5/8" X 32" rerod with P.S. cap #33981 Wit: 6" Maple            S64°W      10.63' 18" Red Pine         N18°E      28.57' 12" Oak               N71°E      49.92' 2" Maple             S35°E      34.09' Carsonite Post         North      1'±
---	---

Signed by: Carl T. Kiiskila  
 Surveyor's Michigan License No.: 33981

Date: 3-7-02

