

# LAND CORNER RECORDATION CERTIFICATE

Filing Requirement of Act 74, Mich. PA 1970

For Corners In: Montmorency (County)	Located In	Corner Code #
1. Public Land Survey	T _____ R _____	_____
2. Property Controlling in Section	S _____ T _____ R _____	_____
3. Miscellaneous Property in Section	S <u>32</u> T <u>30N</u> R <u>3E</u>	<u>8</u>
	S _____ T _____ R _____	_____
	S <u>32</u> T <u>30N</u> R <u>3E</u>	<u>11</u>
	S _____ T _____ R _____	_____


4. Lot No: \_\_\_\_\_ Recorded Plat: \_\_\_\_\_

5. Private Claims: \_\_\_\_\_

I, Carl T. Kiiskila, in a field survey on March 17, 2011 do hereby state that under requirements of PA 74, Michigan PA of 1970, the corner points mentioned in lines 1 and 2 above were in conformance with regulations and rules therefore as required in the current manual of survey instructions of the United States Department of the Interior, Bureau of Land Management or by a decree of a Court of Law and/or that the corner points mentioned in lines 3, 4 and 5 above were in conformance with the rules of the Michigan Board of Land Surveyors or by a Decree of a Court of Law; established, re-established, monumented, recovered, found as expressed below:

**NOTE: Not more than 2 corners, all in the same town and range, may be recorded on this certificate.**

Register of Deeds Stamp & File Number

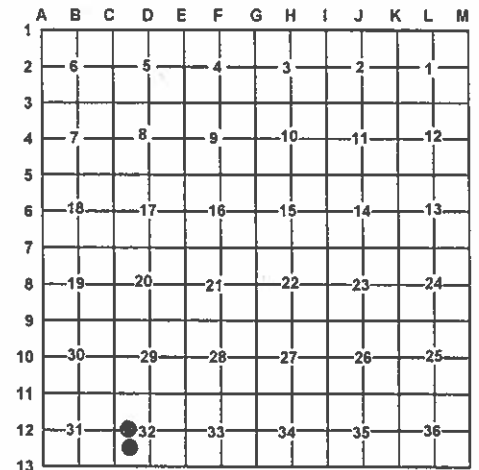

A. Description of original monument and accessories and/or subsequent restoration:

<u>8</u> - CW 1/16 corner, section 32, T30N,R03E	<u>11</u> - SW 1/16 corner, section 32, T30N,R03E
Unknown Date - Section Break - Delmer E. Porter, P.S.#15410 Shows breakdown of section 32, T30N, R03E, does not show setting CW 1/16 corner.	None

B. Description of corner evidence found and/or method applies in restoring or re-establishing corner:

<u>8</u> - CW 1/16 corner, section 32, T30N,R03E	<u>11</u> - SW 1/16 corner, section 32, T30N,R03E
Found and accpeted 1/2" x 24" capped iron rebar with cap#15410 set by Delmer E. Porter, P.S.#15410. Replaced found CIR with a 2" dia. stamped aluminum cap on a 5/8"x34" rebar. Found no other evidence to dispute the location for the corner.	Set 2" dia. aluminum cap on 5/8"x 34" rebar per standard BLM procedure. Corner falls in N-S single strand fence. Found no other evidence to dispute the location for the corner.

C. Description of monument for corner and accessories established to perpetuate locating the position of the corner:

<u>8</u> - CW 1/16 corner, section 32, T30N,R03E	<u>11</u> - SW 1/16 corner, section 32, T30N,R03E
2" dia. stamped aluminum cap on 5/8"x34" rebar.	2" dia. stamped aluminum cap on 5/8"x34" rebar.

Witnesses:

N24°E 13.34' to set N&T on NW side 7" R. Maple  
S74°E 7.60' to set N&T on N side 8" R. Maple  
S04°E 51.77' to set N&T on W side 7" R. Maple  
West 6.30' to set N&T on N side 10" R. Maple  
Set Blue Carsonite Post w/ location tag 1' North

Witnesses:

N35°E 16.33' to set N&T on SE side 7" R. Maple  
S56°E 38.55' to set N&T on NE side 5" Oak  
S02°W 40.55' to set N&T on W side 7" R. Maple Clump  
S88°W 34.26' to set N&T on N side 22" Oak  
Set Blue Carsonite Post w/ location tag 1' North

Carl T. Kiiskila

Surveyor's Michigan License No.: 33981

4-27-11

