

LAND CORNER RECORDATION CERTIFICATE


Filing Requirement of Act 74, Mich. PA 1970

For Corners In: Montmorency (County)	Located In	Corner Code #	
1. Public Land Survey	T <u>30N</u> R <u>3E</u>	<u>C-13</u>	
2. Property Controlling in Section	S _____ T _____ R _____	_____	
3. Miscellaneous Property in Section	S <u>32</u> T <u>32N</u> R <u>3E</u>	<u>12</u>	
4. Lot No: _____	Recorded Plat: _____		
5. Private Claims: _____			



I, Carl T. Kiiskila, in a field survey on March 22, 2011 do hereby state that under requirements of PA 74, Michigan PA of 1970, the corner points mentioned in lines 1 and 2 above were in conformance with regulations and rules therefore as required in the current manual of survey instructions of the United States Department of the Interior, Bureau of Land Management or by a decree of a Court of Law and/or that the corner points mentioned in lines 3, 4 and 5 above were in conformance with the rules of the Michigan Board of Land Surveyors or by a Decree of a Court of Law; established, re-established, monumented, recovered, found as expressed below:

NOTE: Not more than 2 corners, all in the same town and range, may be recorded on this certificate.

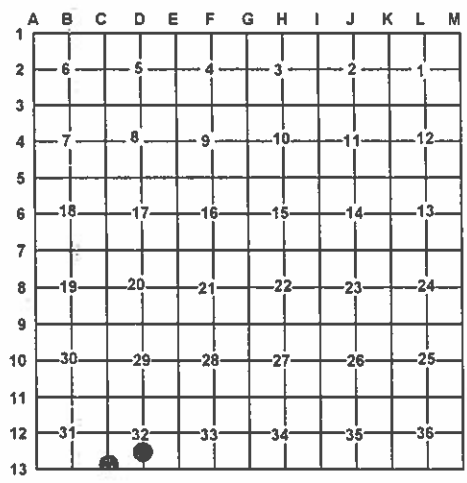

A. Description of original monument and accessories and/or subsequent restoration:

- | | |
|--|--|
| <p><u>C-13</u> – SW section corner, section 32, T30N,R03E</p> <p>1960 – Department of Conservation Land Corner Record – Kenneth J. Ostling, P.S.#10068 – This corner was restored from remains of possible NW government BT. This point also checks exactly for E-W proportion and is government measure from pipe at section corner 1 mile North. Nothing to mark North of town line for witness.</p> <p>1977 – L.C.R.C. – L.1, p.194 – Delmer E. Porter, P.S.#15410 – Cons. Mon. & 5" Sq. Stake & 2 witnesses.
S60°E 22.64' 14" Poplar
S85°W 46.21' 14" Poplar
N14°E 9.59' 5" Poplar</p> | <p><u>12</u> – CS 1/16 corner, section 32, T30N,R03E</p> <p>1989 – L.C.R.C. – L.1, p.448 – Donald E. Marlatt, P.S.# 18660 – Set 1/2" rod & cap by standard procedure.
N50°E 6.7' 12" Poplar
N15°W 10.0' 15" Poplar
S05°W 25.1' 10" Poplar</p> |
|--|--|

B. Description of corner evidence found and/or method applies in restoring or re-establishing corner:

- | | |
|--|---|
| <p><u>C-13</u> – SW section corner, section 32, T30N,R03E</p> <p>Found Department of Conservation monument per 1960 Land Corner Record by Ostling. Accepted found D.O.C. monument as a careful and faithful perpetuation of the position of the original corner. Found no other evidence to dispute the location for the corner.</p> | <p><u>12</u> – CS 1/16 corner, section 32, T30N,R03E</p> <p>Searched area for Marlatt's iron but did not find, only found witness nails in dead or dying poplars. Set stamped 2" dia. aluminum cap on 5/8"x34" rebar per standard BLM procedure. Position fits well with Marlatt's witnesses. Found no other evidence to dispute the location for the corner.</p> |
|--|---|

C. Description of monument for corner and accessories established to perpetuate locating the position of the corner:

- | | |
|---|--|
| <p><u>C-13</u> – SW section corner, section 32, T30N,R03E</p> <p>4" dia. stamped alum. cap on 1" galvanized pipe.</p> | <p><u>12</u> – CS 1/16 corner, section 32, T30N,R03E</p> <p>2" dia. aluminum cap on 5/8"x 34" rebar.</p> |
|---|--|

Witnesses:

- | | |
|--|---|
| <p>S13°W 31.13' to set N&T on W side 5" B. Cherry
N15°W 3.96' to set N&T on W side 5" B. Cherry
S82°W 52.46' to set N&T on N side 6" B. Cherry
S82°E 6.86' to set PK&T on S side 6"x 6' cedar guard post
N73°W 23.08' to fd. N&T#18654 on SW side 15" Aspen
N89°E 6.56' fd. DOC. mon. (C.C.) NW corner sec. 5, T29N,R3E
Set blue carsonite post 1' North</p> | <p>Witnesses:
N18°E 25.16' to set N&T on SE side 3" Oak
*S63°E 7.09' to fd. nail on N side 14" Poplar (cut down)
S26°E 24.03' to set N&T on SW side 5" W. Pine
*S02°W 25.18' to fd. nail on E side 11" Poplar (dead)
S46°W 39.12' to set N&T on SE side 6" B. Flr
N60°W 88.25' to set N&T on NE side 18" R. Pine
*N15°W 9.98' to fd. nail on E side 11" Poplar
Set Blue Carsonite Post w/ location tag 1' North</p> |
|--|---|

Carl T. Kiiskila
Surveyor's Michigan License No.: 33981

* Witness of previous record.
4-27-11

