

LAND CORNER RECORDATION CERTIFICATE


Filing Requirement of Act 74, Mich. PA 1970

For Corners In: Montmorency (County)	Located In	Corner Code #
1. Public Land Survey	T 31N R 1E	I-1
	T 31N R 1E	I-2
2. Property Controlling in Section	S _____ T _____ R _____	_____
	S _____ T _____ R _____	_____
3. Miscellaneous Property in Section	S _____ T _____ R _____	_____
	S _____ T _____ R _____	_____
4. Lot No: _____	Recorded Plat: _____	
5. Private Claims: _____		

Instrument Liber Page
 201100047921 1 751

 201100047921
 Filed for Record in
 MONTMORENCY COUNTY, MI
 TERESA WALKER, REGISTER OF DEEDS
 08-18-2011 At 09:02:44 am.
 LAND CORNER 14.00
 Liber 1 Page 751 - 751

Register of Deeds Stamp & File Number

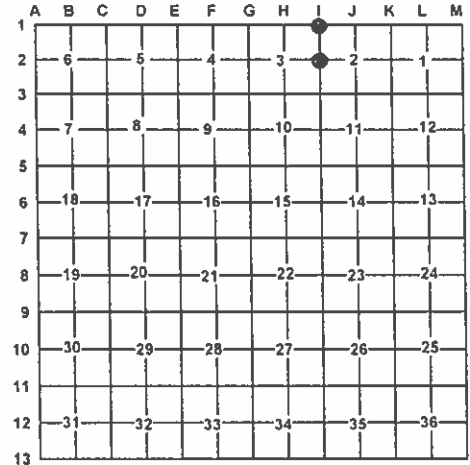

I, Carl T. Kiiskila, in a field survey on July 28, 2011 do hereby state that under requirements of PA 74, Michigan PA of 1970, the corner points mentioned in lines 1 and 2 above were in conformance with regulations and rules therefore as required in the current manual of survey instructions of the United States Department of the Interior, Bureau of Land Management or by a decree of a Court of Law and/or that the corner points mentioned in lines 3, 4 and 5 above were in conformance with the rules of the Michigan Board of Land Surveyors or by a Decree of a Court of Law; established, re-established, monumented, recovered, found as expressed below:

NOTE: Not more than 2 corners, all in the same town and range, may be recorded on this certificate.

A. Description of original monument and accessories and/or subsequent restoration:

- | | |
|---|--|
| <p><u>I-1</u> – Sec. cor. comm. to sec.'s 2 & 3, T31N,R01E & sec.'s 34 & 35, T32N, R01E</p> <p>1850 – GLO – Austin Burt – Set post corner of 34 and 35.
 SP. Pine 12 N31°E 2.29
 SP. Pine 12 S40°W 2.25</p> <p>1977 – Unrecorded Certificate of Survey – Donald E. Marlatt, P.S. #18660
 - Set ½" rod and cap. 18' North to fence.
 N80°E 33.86' 12" J. Pine
 S45°W 15.0' 10" J. Pine
 S25°E 27.75' 10" J. Pine</p> <p>1990 – Field Notes – MDNR – Carl R. Johnson, P.S.#30083 – Found ½" rod for corner. No witnesses given.</p> | <p><u>I-2</u> – Quarter corner comm. to sec.'s 2 & 3, T31N,R01E</p> <p>1850 – GLO – Austin Burt – Set quarter section post.
 S. Pine 11 N25°E 35
 S. Pine 11 S25°W 27</p> <p>1989 – L.C.R.C. – L.1, p.444 – MDNR – Carl R. Johnson, P.S. #30083
 - Set DNR monument by proportionate measurement.
 4" W. Pine S51°E 44.3'
 12" R. Pine N60°E 36.7'
 8" R. Pine N26°E 29.5'
 4" R. Pine N86°W 56.2'</p> |
|---|--|

B. Description of corner evidence found and/or method applies in restoring or re-establishing corner:

- | | |
|--|--|
| <p><u>I-1</u> – Sec. cor. comm. to sec.'s 2 & 3, T31N,R01E & sec.'s 34 & 35, T32N, R01E</p> <p>Found ½" CIR #18660 per 1977 unrecorded Certificate of Survey by Marlatt. Accepted found CIR as a careful and faithful reestablishment of the position of the original corner. Drove standard DNR monument on 4' long 1" pipe over found CIR. Found no other evidence to dispute the location for the corner.</p> | <p><u>I-2</u> – Quarter corner comm. to sec.'s 2 & 3, T31N,R01E</p> <p>Found DNR monument per L.C.R.C. – L.1, p.444. Accepted found DNR monument as a faithful and careful reestablishment of the position of the original corner. Found no other evidence to dispute the location for the corner.</p> |
|--|--|

C. Description of monument for corner and accessories established to perpetuate locating the position of the corner:

- | | |
|---|---|
| <p><u>I-1</u> – Sec. cor. comm. to sec.'s 2 & 3, T31N,R01E & sec.'s 34 & 35, T32N, R01E</p> <p>Stamped 4" dia. alum. DNR cap on 1" x 4' galvanized pipe.</p> <p>Witnesses:
 N61°E 33.85' to set N&T on SE side 9" J. Pine
 S42°E 36.48' to set N&T on W side 10" W. Pine
 S19°W 30.43' to set N&T on E side 16" J. Pine
 S60°W 89.41' to set N&T on S side 8" R. Pine
 S70°E 35.10' to fd. blaze on 14" J. Pine snag
 Set blue carsonite post 1' North</p> <p>* Witness of previous record.</p> | <p><u>I-2</u> – Quarter corner comm. to sec.'s 2 & 3, T31N,R01E</p> <p>Stamped 4" dia. alum. DNR cap on 1"x 36" galvanized pipe.</p> <p>Witnesses:
 *N18°E 29.95' to set N&T on W side 16" R. Pine
 *N50°E 37.80' to set N&T on SE side 20" R. Pine
 *S57°E 44.66' to set N&T on SW side 11" W. Pine
 *S78°W 56.50' to set N&T on S side 15" R. Pine
 Set blue carsonite post 1' North</p> <p>* Witness of previous record.</p> |
|---|---|

Carl T. Kiiskila

Surveyor's Michigan License No.: 33981

8-11-11

