

MAR 13 2000

1999 Newaygo County Remonumentation Project

NEWAYGO COUNTY  
REGISTER OF DEEDS  
LINDA M. BROWN

SECTION

LAND CORNER RECORDATION CERTIFICATE  
FILING REQUIREMENT of Act 74, Mich. P.A. 1970

00 FEB 28 PM 1 09

For corners in  
Newaygo  
(County)

Located in:

Corner Code #

*Linda M. Brown*

1. Public Land Survey

T 11N R 11W

K-13

VOL. 2

289

2. Property Controlling  
in Section

S T R

3. Miscellaneous  
Property in Sec.

S T R

4. Lot No. , Recorded Plat

5. Private Claims

Register of Deeds Stamp & File Number

	A	B	C	D	E	F	G	H	I	J	K	L	M
1													
2	6	5	4	3	2	1							
3													
4	7	8	9	10	11	12							
5													
6	18	17	16	15	14	13							
7													
8	19	20	21	22	23	24							
9													
10	30	29	28	27	26	25							
11													
12	31	32	33	34	35	36							
13													

I, Norman L. Ochs, in a field survey on August 17, 1999, do hereby certify that under requirements of P. A. 74, Michigan P.A. of 1970, the corner points mentioned in lines 1 and 2 above were in conformance with regulations and rules therefore as required in the current manual of survey instructions of the United States Department of the Interior, Bureau of Land Management or by a decree of a Court of Law and/or that the corner points mentioned in lines 3, 4 and 5 above were in conformance with the rules of the Michigan Board of Land Surveyors or by a Decree of a Court of Law; established, re-established, monumented, re-monumented, recovered, found as expressed below:

**Note: Not more than 4 corners, all in the same town and range, may be recorded on this certificate.**

Southeast Corner, Section 35, Ensley Township, Newaygo County, Michigan.

**A. DESCRIPTION OF ORIGINAL MONUMENT AND ACCESSORIES AND/OR SUBSEQUENT RESTORATION:**

G.L.O. N. Brookfield 1836  
10" Maple N24°E 17 Links (11.22')#1  
12" Cherry N44°W 23 Links (15.18')#2

Delos G. Anderson (County Surveyor)  
Book A, Page's 349 and 350 July 28 thru 31, 1902  
Corner Pine Stump Fence N53°W 63 Links (41.58') #3  
Pine Stake South 28' #4

Delos G. Anderson (County Surveyor)  
Book A, Pages 249 and 250 May 1 thru 4, 1899  
Stone N53°W 63 Links (41.58')#3  
Pine Stake South 28' #4

William M. Jacques (County Surveyor)  
Book 16, Page's 27 thru 30 May 29, 1908  
3" Walnut N51°15'E 72 Links (47.52')#5  
3" Maple S41°W 59 Links (38.94')#6

Newaygo County Road Commission Sheet  
Telephone Pole South 21.2' #7  
Telephone Pole N80°E 83.9' #8

OVER

**B. DESCRIPTION OF CORNER EVIDENCE FOUND AND/OR METHOD APPLIED IN RESTORING OR REESTABLISHING CORNER:**

Found 4" x 4" base of broken Harrison cast iron monument, in centerline of the East and West bituminous road and in the centerline of bituminous road going North. The condition of the recorded witnesses are: #1 thru #4 gone, #5 good condition, #6 thru #8 gone, #9 good condition, #10 leaning, #11 and #12 good condition.

**C. DESCRIPTION OF MONUMENT FOR CORNER AND ACCESSORIES ESTABLISHED TO PERPETUATE LOCATING THE POSITION OF THE CORNER:**

Removed old base and set a 4" Harrison cast iron monument 20" long marked "County Surveyor" as a substantial marker for the section corner and is accepted as a careful and faithful reestablishment of the original corner.

36" Walnut N55°E 47.36' Found spike with tag #22439 in Southeasterly side of tree, Set new spike with tag #22439 over existing spike. #5  
42" Maple N18°W 82.60' Found spike with tag #22439 in East side of tree, Set new spike with tag #22439 over existing spike. #9  
Telephone Riser (leaning) N45°W 56.83' #10  
Southwest Corner House N65°E 188.60' #11  
North One Quarter Corner, Solon Township, Harrison monument with Kent County brass cap East 179.31' #12

Signed by Norman L. Ochs


Date August 17, 1999

Surveyor's Michigan License No. 22439

Form approved by Michigan State Board of Land Surveyors, Jan 28, 1971  
Revised May 14, 1975  
Revised Jan., 1983

Approved by Peer Review Group on August 19, 1999  
Norman L. Ochs, County Representative.

*M. L. O.*

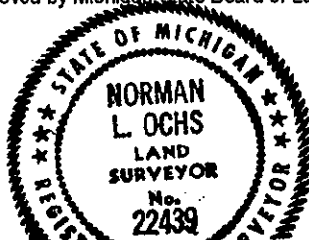

A. Description (cont.)

Norman L. Ochs R.L.S. #22439

LCRC #695 November 14, 1985

Found P.K. nail in the centerline of the East and West road and 1.5 feet West of road going North. Dug for stone, found large stone on end 1.62 feet South and 0.63 feet East of the P.K. nail. Held position of stone for true corner. Set a 4" x 20" Harrison cast iron monument marked "County Surveyor" over the stone (laid flat).

24" Walnut N45°E 47.34' #5

36" Maple N30°W 82.55' #9

Telephone Riser N45°W 55.58' #10

Southwest Corner House N60°E 188.65' #11

North One Quarter Corner, Section 2, Solon Township, East 179.29' #12

SURVEY &  
REMONUMENTATION

MAR 13 2000

SECTION