

REMONUMENTATION  
MAY 28 1997  
COMMISSION

NEWAYGO COUNTY  
REGISTER OF DEEDS  
LINDA M. BROWN  
'97 FEB 12 PM 4 45

1996 Newaygo County Remonumentation Project  
LAND CORNER RECORDATION CERTIFICATE  
FILING REQUIREMENT of Act 74, Mich. P.A. 1970

*Linda M. Brown*

For corners in <u>Newaygo</u> (County)	Located in:	Corner Code #
1. Public Land Survey	T <u>14N</u> R <u>12W</u>	<u>C-13</u>
	T _____ R _____	_____
	T _____ R _____	_____
	T _____ R _____	_____
2. Property Controlling in Section	S _____ T _____ R _____	_____
	S _____ T _____ R _____	_____
3. Miscellaneous Property in Sec.	S _____ T _____ R _____	_____
	S _____ T _____ R _____	_____
4. Lot No. _____, Recorded Plat _____		
5. Private Claims _____		

VOL. 2 PAGE 5

Register of Deeds Stamp & File Number

	A	B	C	D	E	F	G	H	I	J	K	L	M
2	0	1	2	3	4	5	6	7	8	9	10	11	12
3													
4	1	2	3	4	5	6	7	8	9	10	11	12	13
5													
6	10	11	12	13	14	15	16	17	18	19	20	21	22
7													
8	19	20	21	22	23	24	25	26	27	28	29	30	31
9													
10	30	31	32	33	34	35	36	37	38	39	40	41	42
11													
12	31	32	33	34	35	36	37	38	39	40	41	42	43
13													

I, Norman L. Ochs, in a field survey on October 9, 1996, do hereby certify that under requirements of P. A. 74, Michigan P.A. of 1970, the corner points mentioned in lines 1 and 2 above were in conformance with regulations and rules therefore as required in the current manual of survey instructions of the United States Department of the Interior, Bureau of Land Management or by a decree of a Court of Law and/or that the corner points mentioned in lines 3, 4 and 5 above were in conformance with the rules of the Michigan Board of Land Surveyors or by a Decree of a Court of Law; established, re-established, monumented, re-monumented, recovered, found as expressed below:

Note: Not more than 4 corners, all in the same town and range, may be recorded on this certificate.

Southeast Corner, Section 31, City of White Cloud, Newaygo County, Michigan

A. DESCRIPTION OF ORIGINAL MONUMENT AND ACCESSORIES AND/OR SUBSEQUENT RESTORATION:

- G.L.O. John Hodgson 1838  
14" Pine N17°E 14 Links (9.24') #1  
7" Pine N35°W 13 Links (8.58') #2
- Newaygo Engineering and Survey Company 1979  
Power Pole S10°E 29.95' #7  
Power Pole S55°W 52.69' #8  
Northeast Corner, Section 6, Everett Township West 19.14' #6
- Ralph A. Smith R.L.S. #3421  
Found Gas Pipe  
24" Black Oak South 32.4' #3  
15" Norway Pine S55°W 61.7' #4  
14" White Oak N25°E 67.20' #5  
Northeast Corner, Section 6, Everett Township West 19.14' #6
- Newaygo Engineering and Survey Company 1985  
Top Center Fire Hydrant 42.52' #9
- Newaygo Engineering and Survey Company  
October 4, 1994 LCRC #1233  
Northeast Corner, Section 6, Everett Township (Railroad Spike) West 19.19' #6  
Guy Pole S10°E 29.98' #7  
Power Pole S55°W 52.71' #8  
Black Oak S55°W 94.08' #10

B. DESCRIPTION OF CORNER EVIDENCE FOUND AND/OR METHOD APPLIED IN RESTORING OR REESTABLISHING CORNER:

Found 1/2" Rod over a Pinch Pipe with Glass (possible pointed stone next to Pinch Pipe) and the centerline of road going East and West is 2.5 feet South and the centerline of road going North and South is 13 feet West and the condition of the recorded witnesses are: #1 thru #4 gone, #5 thru #10 good condition.

C. DESCRIPTION OF MONUMENT FOR CORNER AND ACCESSORIES ESTABLISHED TO PERPETUATE LOCATING THE POSITION OF THE CORNER:


Removed 1/2" Rod and Pinch Pipe and set a 4" diameter Harrison cast iron monument 20" long marked "County Surveyor" as a substantial marker for the section corner and is accepted as a careful and faithful reestablishment of the original corner.

- 20" White Oak N42°E 68.36' Found spike in West side of tree. #5
- Railroad spike, Northeast Corner, Section 6, T13N R12W, West 19.14' #6
- Power Pole S15°E 29.95' Found spike in West side of pole. #7
- Power Pole S61°W 52.89' Found spike in Southeast side of pole. #8
- Top Center Fire Hydrant S40°E 42.52' #9
- 34" Black Oak S55°W 94.08' Found spike in Southeast side of tree. #10

Signed by Norman L. Ochs Date October 17, 1996

Surveyor's Michigan License No. 22439

Form approved by Michigan State Board of Land Surveyors, Jan 2, 1971

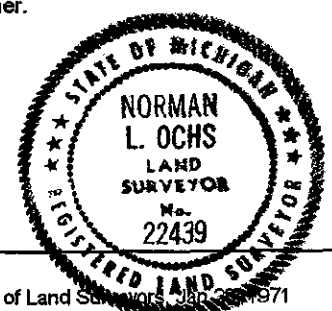

Approved by Peer Review Group On October 24, 1996  
Norman L. Ochs, County Representative.

Revised May 14, 1975  
Revised Jan., 1983

*N.L.O.*