

MAR 13 2000

1999 Newaygo County Remonumentation Project

NEWAYGO COUNTY
REGISTER OF DEEDS
LINDA M. BROWN

SECTION

LAND CORNER RECORDATION CERTIFICATE
FILING REQUIREMENT of Act 74, Mich. P.A. 1970

00 FEB 28 PM 1 18

For corners in
Newaygo
(County)

Located in:

Corner Code #

Linda M. Brown

1. Public Land Survey

T 16N R 11W

G-9

VOL. 2

370

2. Property Controlling
in Section

S T R

3. Miscellaneous
Property in Sec.

S T R

S T R

Register of Deeds Stamp & File Number

4. Lot No. , Recorded Plat

5. Private Claims

I, Norman L. Ochs, in a field survey on June 6, 1999,
do hereby certify that under requirements of P. A. 74, Michigan P.A. of 1970, the corner
points mentioned in lines 1 and 2 above were in conformance with regulations and rules
thereof as required in the current manual of survey instructions of the United States
Department of the Interior, Bureau of Land Management or by a decree of a Court of
Law and/or that the corner points mentioned in lines 3, 4 and 5 above were in
conformance with the rules of the Michigan Board of Land Surveyors or by a
Decree of a Court of Law; established, re-established, monumented, re-monumented,
recovered, found as expressed below:

	A	B	C	D	E	F	G	H	I	J	K	L	M
1													
2	6	5	4	3	2	1							
3													
4	7	8	9	10	11	12							
5													
6	18	17	16	15	14	13							
7													
8	19	20	21	22	23	24							
9													
10	30	29	28	27	26	25							
11													
12	31	32	33	34	35	36							
13													

Note: Not more than 4 corners, all in the same town and range, may be
recorded on this certificate.

Southeast Corner, Section 21, Barton Township, Newaygo County, Michigan.

A. DESCRIPTION OF ORIGINAL MONUMENT AND ACCESSORIES AND/OR SUBSEQUENT RESTORATION:

G.L.O. Milton Nye 1856
9" Beech S44°E 47 Links (31.02') #1
6" Beech N40½°W 10 Links (6.60') #2

Newaygo County Road Commission Sheet
Pipe (1909)

William M. Jacques (Co. Surveyor)
Book B Page's 46 & 47 June 24, 1909
Iron gas pipe Survey of Section 21
Measured 19.59 Chains (1292.94') from the South One
Quarter Corner to the East One Eighth Corner on the
South section line and same to the Southeast Corner.
He set the One Eighth Corner halfway and on line even
thou G.L.O. shows it to be 20.00 Chains (1320') from
the South One Quarter Corner to the East One Eighth
Corner and 18.92 Chains (1248.72') from the One
Eighth Corner to the Southeast Corner on the South
section line.

Jerry L. Wilcox RLS #14102
LCRC #538 July 1981
Set ½" rod and cap in centerline of North and South road and 3' North
of centerline of East and West road. Doubled over One Quarter
Corner and One Eighth Corner to West. Measured 1294.07 feet from
the South One Quarter Corner to the East One Eighth Corner on the
South section line.
Power Pole S40°E 83.84' #3
Corner fence post N50°E 49.89' #4
24" Maple N25°W 53.00' #5
Telephone Pole N50°W 45.74' #6

OVER

B. DESCRIPTION OF CORNER EVIDENCE FOUND AND/OR METHOD APPLIED IN RESTORING OR REESTABLISHING
CORNER:

Found Robert A. Griffin's concrete monument in centerline of gravel road South and the centerline of the road to the North is
1.5 feet West of corner and the corner is 3 feet North of the centerline of East and West gravel road. The condition of the
recorded witnesses are: #1 and #2 gone, #3 good condition, #4 (bent), #5 thru #7 good condition. I feel Wilcox's position and
method to restore the corner was correct, because it put it back to the position used in 1909.

C. DESCRIPTION OF MONUMENT FOR CORNER AND ACCESSORIES ESTABLISHED TO PERPETUATE LOCATING
THE POSITION OF THE CORNER:

Accepted Robert A. Griffin's concrete monument as a substantial marker for the section corner and is accepted as a careful
and faithful reestablishment of the position of the original corner.

Power Pole S40°E 83.82' Spike in Northeast side of pole. #3
24" Maple N25°W 52.87' Spike in Northwest side of tree. #5
Power Pole N52°W 45.72' Spike in Southwest side of pole. #6
1916 United States Government Survey monument #16 N50°W 34.10' #7

Signed by

Norman L. Ochs
Norman L. Ochs


Date August 16, 1999

Surveyor's Michigan License No. 22439

Form approved by Michigan State Board of Land Surveyors

Approved by Peer Review Group On November 30, 1999

Norman L. Ochs, County Representative.

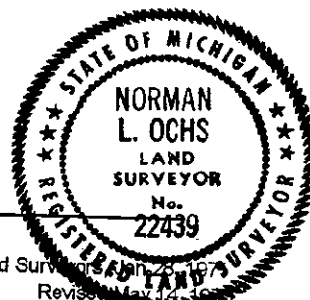

Revised Jan., 1983

SURVEY &
REMONUMENTATION

A. Description (cont.)

MAR 13 2000

SECTION

Robert A. Griffin RLS #13584
LCRC #535 January 1, 1981
Found 1/2" Rerod by Wilcox from his witnesses.
Removed and set a 5" x 36" concrete monument with brass cap.
Fence corner post N58°E 49.91' #4
Power Pole S40°E 83.83' #3
Power Pole N52°W 45.73' #6
1916 United States Government Survey elevation monument #16 N50°W 33.95' #7