

SURVEY & REMONUMENTATION

MAR 19 1998

1997 Newaygo County Remonumentation Project

NEWAYGO COUNTY
REGISTER OF DEEDS
LINDA M. BROWN

'98 MAR 6 PM 12 39

SECTION

LAND CORNER RECORDATION CERTIFICATE
FILING REQUIREMENT of Act 74, Mich. P.A. 1970

Linda M. Brown

VOL. 2

152

For corners in
Newaygo
(County)

Located in:

Corner Code #

1. Public Land Survey T 16N R 11W M-11

2. Property Controlling in Section S T R

3. Miscellaneous Property in Sec. S T R

4. Lot No. _____, Recorded Plat _____

5. Private Claims _____

Register of Deeds Stamp & File Number

	A	B	C	D	E	F	G	H	I	J	K	L	M
1													
2	6		5		4		3		2		1		
3													
4	7		8		9		10		11		12		
5													
6	18		17		16		15		14		13		
7													
8	19		20		21		22		23		24		
9													
10	30		29		28		27		26		25		
11													
12	31		32		33		34		35		36		
13													

I, Norman L. Ochs, in a field survey on October 3, 19 97, do hereby certify that under requirements of P. A. 74, Michigan P.A. of 1970, the corner points mentioned in lines 1 and 2 above were in conformance with regulations and rules therefore as required in the current manual of survey instructions of the United States Department of the Interior, Bureau of Land Management or by a decree of a Court of Law and/or that the corner points mentioned in lines 3, 4 and 5 above were in conformance with the rules of the Michigan Board of Land Surveyors or by a Decree of a Court of Law; established, re-established, monumented, re-monumented, recovered, found as expressed below:

Note: Not more than 4 corners, all in the same town and range, may be recorded on this certificate.

Northeast Corner, Section 36, Barton Township, Newaygo County, Michigan

A. DESCRIPTION OF ORIGINAL MONUMENT AND ACCESSORIES AND/OR SUBSEQUENT RESTORATION:

G.L.O. John Hodgson 1838
10" Beech S40°W 30 Links (19.80')#1
8" Beech N64°W 22 Links (14.52')#2

Lyle S. Shepherd R.L.S. #503
Book 37 Page 3 April 9, 1917
Stone and Stake
30" Elm N22¾°E 77½ Links (51.15')#3

William M. Jacques (County Surveyor)
September 12, 1908 Book B Pages 36 and 37
Stone and Iron stake glass around

P. Holland
April 1919 (Mecosta County Records)
10" Maple S40°E 35' #2
12" Beech N40°W 40' #3

James L. Fletcher R.L.S. #19830
Recorded in Liber 10 Page 145 at Mecosta County Records June 4, 1973
32" Elm Stump N40°W 47.95' #4
36" Maple S20°W 90.47' #5
34" Maple S15°E 110.49' #6

OVER

B. DESCRIPTION OF CORNER EVIDENCE FOUND AND/OR METHOD APPLIED IN RESTORING OR REESTABLISHING CORNER:

Found ½" X 18" Rerod inside 1" X 10" Iron pipe over 1" X 24" Rerod next to a 1" X 20" Shaft, also found a large stone and crockery. The centerline of the East and West bituminous road is 1 foot North and the centerline of the North and South gravel road is 1 foot West. The condition of the recorded witnesses are: #1 thru #4 gone, #5 stump, #6 thru #9 good condition, #10 leaning, #11 gone, #12 and #13 good condition.

C. DESCRIPTION OF MONUMENT FOR CORNER AND ACCESSORIES ESTABLISHED TO PERPETUATE LOCATING THE POSITION OF THE CORNER:

Removed Rerods, Pipe and Shaft and set a 4" diameter Harrison cast iron monument 20" long marked "County Surveyor" over large stone and crockery as a substantial marker for the section corner and is accepted as a careful and faithful reestablishment of the original corner.

42" Maple Stump S26°W 90.55' to center of stump. #5
40" Maple S11°E 110.57' Found spike in West side of tree. #6
Fence post (leaning) N45°E 51.77' Found spike in Southeast side of post. #10
Triple Marker Concrete S42°E 59.5' #12
Triple Marker Concrete S60°W 51.15' #13
26"-24" Twin Walnut S76°W 107.46' Set spike and tag in Southeast side of tree.

Signed by Norman L. Ochs Date October 7, 1997

Norman L. Ochs

Surveyor's Michigan License No. 22439


Form approved by Michigan State Board of Land Surveyors, Jan 28, 1971

Revised May 14, 1975

Revised Jan., 1983

Approved by Peer Review Group on December 18, 1997

Norman L. Ochs, County Representative.

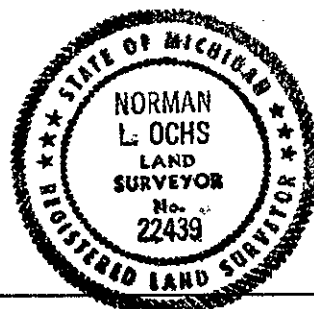

NO

A. Description (cont.)

Newaygo County Road Commission Sheet

Iron

30" Elm N40°W 46.4' #4

Telephone Pole S45°W 47.5' #7

20" Maple S50°E 43.8' #8

Telephone Pole S30°E 55.0' #9

Clinton E. Cole R.L.S. #17615

Recorded in Liber 10 Page 577 LCRC Recorded at Register of Deeds, Mecosta County, Michigan
May 10, 1978

30" Maple S16°E 110.42' #6

36" Maple S21°W 90.57' #5

Fence Post N42°E 51.61' #10

Thomas H. Sage R.L.S. #33139

Recorded in Liber 11 Page 715, Mecosta County Register of Deeds
October 4, 1993

32" Maple S15°E 110.40' #6

38" Maple S20°W 90.55' #5

Fence Post N42°E 51.61' #10

Capped Iron N45°E 46.82' #11