

SURVEY &
REMONUMENTATION

1994 NEWAYGO COUNTY REMONUMENTATION PROJECT

APR 24 1995

COMMISSION

LAND CORNER RECORDATION CERTIFICATE
Filing Requirement of Act 74, Mich. P.A. 1970

VOL 001 PAGE 148

For corners in

Newaygo
(County)

Located In:

Corner Code ##

1. Public Land Survey

T 16N R 13W

J-3

2. Property Controlling
in Section

S T R

3. Miscellaneous
Property in Sec.

S T R

4. Lot No. , Recorded Plat

5. Private Claims

NEWAYGO COUNTY
REGISTER OF DEEDS
MARLENE TOOGOOD

'95 MAR 14 PM 4 00

Marlene Toogood

Register of Deeds Stamp & File Number

I, Norman L. Ochs, in a field survey on April 19, 1994

do hereby certify that under requirements of P.A. 74, Michigan P.A. of 1970, the corner points mentioned in lines 1 and 2 above were in conformance with regulations and rules therefore as required in the current manual of survey instructions of the United States Department of the Interior, Bureau of Land Management or by a decree of a Court of Law and/or that the corner points mentioned in lines 3, 4 and 5 above were in conformance with the rules of the Michigan Board of Land Surveyors or by a Decree of a Court of Law; established, re-established, monumented, re-monumented, recovered, found as expressed below:

NOTE: Not more than 4 corners, all in the same town and range, may be recorded on this certificate.

S-1/4 Cor., Sec. 2, Lilley Twp., Newaygo County MI

A. Description of original monument and accessories and/or subsequent restoration:

GLO Mullett & Brookfield 1857
18" W. Pine S56°E 12 lks (7.92') #1
24" W. Pine N12-1/2°W 31 lks (20.46') #2

Wm. M. Jacques (County Surveyor)
Book 8, Pg. 56 3/23/1906
Measured 39.11 chains (2581.26 ft.) from
the SE cor. to S-1/4 cor. and measured
29.70 chains (2620.20 ft.) from S-1/4 cor.
to SW Cor. Sec. 2


1931 L.S. Shepherd #503
Witness Book, Pg. 27
Ford Axle.
18" P Stp. N14°W 20.7' #2
20" P. Stp. S55°E 41.8' #3
April 1931 L.S. Shepherd
Book 26, Pg. 27
8" W. Oak S22°30' W 39.7' #4
8" B. Oak S30°E 48.2' #5
12" W. Oak N55°W 43.6' #6 -OVER-

B. Description of corner evidence found and/or method applied in restoring or reestablishing corner:
On April 19, 1994 Newaygo Eng. & Survey Co. Found USFS conc. mon w/brass cap,
.80' below road surface in good condition, condition of witnesses is No. 1, 2,
3 & 4 are gone, #5 OK, #6 found OK, #8 found Pine Post USFS tag due North 32.96'

C. Description of monument for corner and accessories established to perpetuate locating the position of the corner:

Accepted USFS 5" sq. x 36" conc. mon as a substantial marker for the corner and
is accepted as a careful and faithful perpetuation of the original corner.

12" B. Oak S38°W 74.08' Spk SE side.
12" B. Oak S30°E 48.34' Spk in SE side.
14" W. Oak N55°W 43.99' Spk NE side.
11" W. Oak N24°E 95.12' Spk. W side.

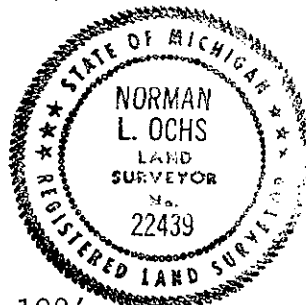

Signed by Norman L. Ochs

Date October 19, 1994

Surveyor's Michigan License No. 22439

Approved by Peer Review Group on October 19, 1994.
Norman L. Ochs, County Representative.

FORM APPROVED BY MICHIGAN STATE BOARD OF LAND SURVEYORS, JAN. 28, 1
REVISED MAY 14, 1
REVISED JAN. 1

A cont.

Measured 2583.96 ft. from NE cor. to N-1/4 cor., Sec. 11 and measured 2587.96 ft. from N-1/4 cor. to NW cor. Sec. 11

5/8/50 R.A. Smith RLS #3421

Ford axle Book 83, Pg. 26

10" W. Oak N50°W 43.65' #6

6" W. Oak S25°W 39.70' #4

6" B. Oak S45°E 48.1' #5

CO. 1 SE 1/4 11 000 20'

Measured 2587.96 ft. from S-1/4 cor. to SW cor., Sec. 2 and measured 2583.96 ft. from S-1/4 cor. to SE cor., Sec. 2.

NCRC Sheet

Ford axle.

8" W. Oak S30°E 40.1' #5

6" W. Oak S25°W 39.7' #4

10" W. Oak N50°W 43.7' #6

N.E. & S. Co. 10/14/77

Fnd. USFS mon.

Job No's 77176AC & 81074B

6" B. Oak S30°E 48.20' #5

6" W. Oak S25°W 39.70' #4

12" W. Oak N50°W 44.02' #6

Measured 2585.03 ft. from SE cor. to S-1/4 cor. and measured 2594.38 ft. from S-1/4 cor. to C-1/4 cor. and measured 2589.23 ft. from S-1/4 cor. to SW cor., all in Sec. 2.

Clinton E. Cole R.L.S. #17615

Recorded in Liber 348 Page 3799

9" W. Oak N24°E 95.20' #7

11" B. Oak S30°E 48.39' #5

12" W. Oak N55°W 44.00' #6

Measured 2589.60 feet from the N. 1/4 Corner to the N.W. Cor. of Sec. 11.

1951 George Blass, RLS #5489

Axle Shaft LCRC #411

6" B. Oak S30°E 40.10' #5

6" W. Oak S25°W 39.70' #4

10" W. Oak N50°W 43.75' #6

Measured 2584.87 ft. from SE cor. to S-1/4 cor., Sec. 2 and measured 2593.90 ft. from S-1/4 cor. to C-1/4 cor. Sec. 2.

R.A. Griffin #13584

Nov. 1, 1976 Found axle shaft replaced with 5" sq. by 36" conc. mon in exact location.

4" x 7' Pine Post North 32.96' #8

9" W. Oak N24°E 95.20' #7

11" B. Oak S30°E 48.39' #5

12" W. Oak N55°W 44.00' #6

N.E. & S. Co. 8/22/78.

Found USFS mon.

Job No's. 78166B & 85053B

10" B. Oak S30°E 48.20' #5

12" W. Oak N50°W 44.02' #6

10" W. Oak N24°E 95.28' #7