

SURVEY & REMONUMENTATION

MAY 24 2000

SECTION

LIBER 20329 PG 646

LAND CORNER RECORDATION CERTIFICATE  
Filing Requirement of Act 74, Mich. P.A. 1970

For corners in

273079

<u>Oakland</u> (County)	Located in: Highland Township	Corner Code # E-3
1. Public Land Survey	T3N R7E	E-3
	T R	
	T R	
	T R	
2. Property Controlling in Section	S T R	
	S T R	
3. Miscellaneous Property in Sec.	S T R	
	S T R	
4. Lot No. _____, Recorded Plat _____		
5. Private Claims _____		

LIBER 20329 PAGE 646  
\$9.00 MISC RECORDING  
\$2.00 REMONUMENTATION  
07/29/1999 11:46:23 A.M. RECEIPT# 58917  
PAID RECORDED - OAKLAND COUNTY  
G. WILLIAM CADDELL, CLERK/REGISTER OF DEEDS

Compliance with  
ACT 345, P.A. 1990

APPROVED ON: 6-6-99 J/K  
OAKLAND COUNTY REMONUMENTATION  
PEER GROUP COMMITTEE

Register of Deeds Stamp & File Number

I, Huston K. Kennedy, in a field survey on March 28, 1999 do hereby state that under requirements of P.A. 74, Michigan P.A. of 1970, the corner points mentioned in lines 1 and 2 above were in conformance with regulations and rules therefore as required in the current manual of survey instructions of the United States Department of the Interior, Bureau of Land Management or by a decree of a Court of Law and/or that the corner points mentioned in lines 3, 4 and 5 above were in conformance with the rules of the Michigan Board of Land Surveyors or by a Decree of a Court of Law; established, re-established, monumented, recovered, found as expressed below.

NOTE: Not more than 2 corners, all in the same town and range, may be recorded on this certificate.

A	B	C	D	E	F	G	H	I	J	K	L	M
1												
2	6		5		4		3		2		1	
3				●								
4	7		8		9		10		11		12	
5												
6	18		17		16		15		14		13	
7												
8	19		20		21		22		23		24	
9												
10	30		29		28		27		26		25	
11												
12	31		32		33		34		35		36	
13												

- A. Description of original monument and accessories and/or subsequent restoration:  
1823-GLO Wampler, D.S.; Set Post 10" White Oak N30°W 6 Links; 11" Black Oak S42°E 61 Links;  
1.) 1974-Feldhauser, PS #10685; LCRC L.6409, Pg.474 - Fnd a 1/2" Iron Rod  
2.) 1990-Newman, PS #24607; LCRC L.11604, Pg.646 - Fnd 1/2" Re-rod, used same wit as 1974 LCRC  
3.) 1993-Bonno, PS #32332; LCRC L.13268, PG.100 - Fnd a 1/2" Re-rod  
4.) 1997-Kapelczak, PS #24598; LCRC L.17129, Pg. 703 - Fnd a 1/2" Re-rod  
5.) Kapelczak, PS #24598; Unrecorded Survey - Object found not stated, no witnesses (Con't on back side of LCRC)
- B. Description of corner evidence found and/or method applied in restoring or reestablishing corner:  
1999-Kennedy Surveying, Inc. - Kennedy, PS #17623 - Fnd a 1/2" Iron Rod w/cap located 8 feet North of the existing centerline of Clyde Road extending to the East & West, which has a gravel surface, and 8 feet East of the existing centerline of Fish Lake Road extending to the North, which has a gravel surface. A fence row extends to the South.


Witnesses from LCRC #1, 2, 3, 4, Survey #6, 13 & 14 were used to recover and verify the location of the found 1/2" Iron Rod.

I accepted the found 1/2" Iron Rod as the best evidence of the original corner position.

Field measurements back side of LCRC

- C. Description of monument for corner and accessories established to perpetuate locating the position of the corner:  
E-3 I replaced the found 1/2" Iron Rod with a 5/8" x 24" Iron Rod w/2" diameter brass cap stamped Oakland County Remonumentation, PS #17623  
N25°W 58.67' Set Mag Nail & Remon Washer NE face 23" Hickory  
N30°E 76.30' Set Mag Nail & Remon Washer NW face Power Pole  
N60°E 70.12' Set Mag Nail & Remon Washer SE face Power Pole  
S02°W 32.13' Set Mag Nail & Remon Washer East face Power Pole

South 32.96' Fnd 1/2" Iron Rod  
South 50.02' Fnd 1/2" Iron Rod

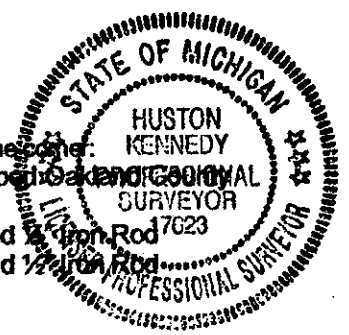

The selected location is accepted by me and is generally accepted by Professional Surveyors as the best available evidence of the position of the original corner.

Signed by: [Signature] Date 6-1-99  
Surveyor's Michigan License No. 17623