

SURVEY &
REMONUMENTATION

JAN 11 1999

SECTION

LAND CORNER RECORDATION CERTIFICATE
Filing Requirement of Act 74, Mich. P.A. 1970

STATE OF MICHIGAN
COUNTY OF OCEANA
RECEIVED FOR RECORD

28 DEC 1998 4:35:28 PM

For corners in
Oceana

Located In: Corner Code #

(County)

15N 18W G-9

1. Public Land Survey

T R
T R
T R
T R

2. Property Controlling
in Section

S T R
S T R

3. Miscellaneous
Property in Sec.

S T R
S T R

JOSEPH E. MERTEN
REGISTER OF DEEDS

100876

Register of Deeds Stamp & File Number

4. Lot No. , Recorded Plat

5. Private Claims

J. Randolph Hepworth July 2, 1998
I, in a field survey on 19 do hereby state that under
requirements of P.A. 74, Michigan P.A. of 1970, the corner points mentioned in lines 1 and 2 above were in
conformance with regulations and rules therefore as required in the current manual of survey instructions of the
United States Department of the Interior, Bureau of Land Management or by a decree of a Court of Law and/or
that the corner points mentioned in lines 3, 4 and 5 above were in conformance with the rules of the Michigan
Board of Land Surveyors or by a Decree of a Court of Law; established, re-established, monumented,
recovered, found as expressed below:

NOTE: Not more than 2 corners, all in the same town and range, may be recorded
on this certificate.

Table with 12 columns (A-L) and 12 rows (1-12) for recording corner points. A dot is marked at the intersection of row 9 and column G.

A. Description of original monument and accessories and/or subsequent restoration:
G-9 CORNER COMMON TO SECTIONS 21, 22, 27, AND 28 T15N, R18W GOLDEN TOWNSHIP

GLO SET POST 20" Birch S56°W 11.8' 16" Birch N73°E 8.6'
Book A, Pg. 360, H.A. Grant, 1894; "Lime Stone 16X7X2".
Book A, Pg. 364, H.A. Grant, 1894; "See #5 Page 361."
Book A, Pg. 408, H.A. Grant, 1895; "See #5 Page 361."
OCRC Witness Book Pre-1950 Limestone 16" X 7" X 2"
36" Beech N80°E 18.2' 12" Oak S5°W 9.5'
Unrecorded Survey, C.M. Stover #2492, 7/29/66 No witnesses
LCRC # 100417, J.R. Hepworth #26457, 5/5/82, Recorded 3/8/90 Fd 1" pipe
Inters. Fence E-W & N-S 18" Beech NNW 6.22'
6" Oak WNW 11.37' 14" Oak S 49.02'
P.Pole ESE 37.02'
Unrecorded Survey, J. R. Hepworth #26457, 11/22/88 and 2/19/98 Fd 1" Pipe
Witnesses Same as LCRC # 100417

Oceana County Remonumentation
Peer Group Reviewed & Approved

Date: 12-10-98

J. Randolph Hepworth
Oceana County Surveyor

B. Description of corner evidence found and/or method applied in restoring or reestablishing corner.


I found a 1" Pipe standing 6" tall at the intersection of old fence lines E-W-N. It was found to be beside a white limestone 2"x7"x16". OCRC pre-1950
witnesses are both rotted stumps and measure OK to the face. This corner is as described by OCRC and by Grant, 1894.

I accept this corner position as being a careful and faithful perpetuation of the position of the original corner. No evidence is known to me that would
lead me to believe that the corner should be at another location.

C. Description of monument for corner and accessories established to perpetuate locating the position of the corner.

Set 4"x20" Harrison Cast iron Monument, stamped "County Surveyor" and "26457" above the Pipe which was driven down and I set the stone back
beside the monument.

60d spk S Face 18" Beech 293°az 6.86 tape
60d spk NE Face 12" Beech 333°az 15.09 tape
60d spk W Face 4" Beech 19°az 19.79 EDM
60d spk S Face 8" Oak 87°az 40.07 EDM
60d spk W Face 4" Oak 167°az 36.44 EDM

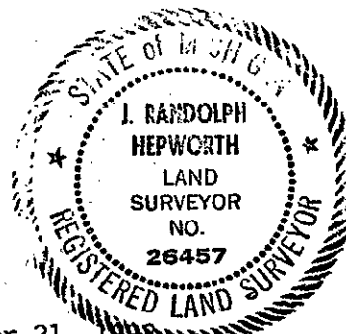

Signed by [Signature]
Surveyor's Michigan License No. 26457

Date December 21, 1998